


Section 2 Township 22 Range 16W

Well No. 2 Shady "A"

Company Iron Drlg.

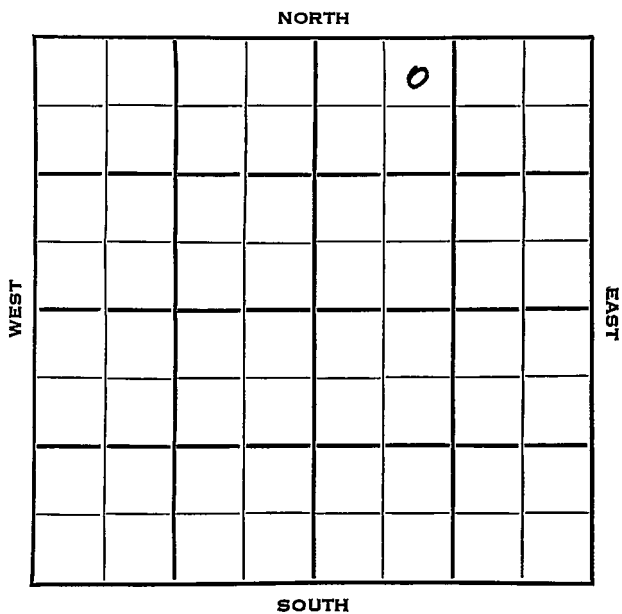

Pawnee KANSAS


SEC. 2	TWP. 22	R. 16W ✓
-----------	------------	-------------

WELL NO. 2 Shady "A" FARM

COMPANY IronDrlg.

CONTRACTOR Iron Drlg.  
Shady Pool

330 Ft. from N. Line  
 \_\_\_\_\_ Ft. from S. Line  
 \_\_\_\_\_ Ft. from E. Line  
 990 Ft. from W. Line

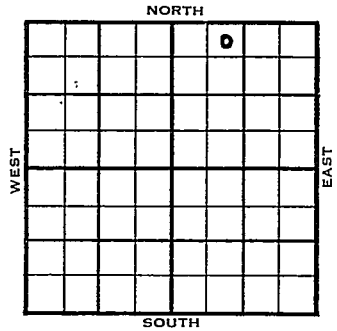

NE NW NE

1954	ELEVATION 1985'	REPORT
------	--------------------	--------

3/17 Spud 3-9-54  
 8" @ 862'  
 Anhy 963'  
 Drlg. 2585'

3/24 Heeb 3381', Br. L. 3488', Lans 3505'  
 Cong 3814'  
 DST 3817'-34' 1 hr, 680' gassy oil  
 70' SOCW 710#  
 Drlg 3856'

4/21 Spud 3-9-54 Oil well TD 3923  
 8" @ 862 Anhy 963 Heeb 3381  
 Br. lime 3488 Lans. 3505 Cong 3814  
 DST 3817-34 open 1 hr rec 680' gassy  
 oil, 70' SOCW 710# Simp. sh. 3848'  
 Simp. sd. 3858'  
 DST 3861-71 open 1½ hr rec 30' mud  
 DST 3869-81 open 1 hr rec 10' mud &  
 wtr. 232' MCW 490# Arb. 3919'  
 DST 3920-23 open 1½ hr rec 90' HOCM  
 60' OCW 1340# TD 3923 5" @ 3923  
 CO to 3923 14/3919-22 6 GOPH  
 PB 3870 40/3818-28 S/5 BOPH  
 12 hr. Comp. 50 BOPD



