


Section 2 Township 22 Range 16W

Well No. #1 Shavy

Company Iran Drlg.

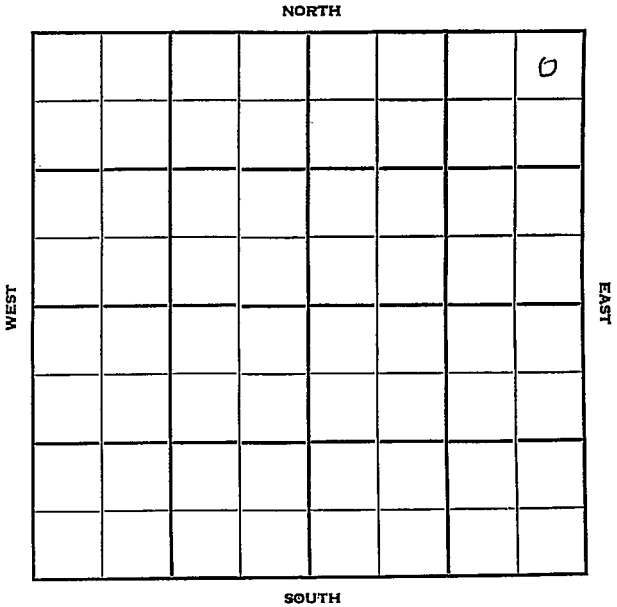

Sec. 2 Twp. 22 R. 16W

Well No. #1 Shavy Farm

Iran Drlg. Company

Iran Contractor


330 Ft. from N. Line

_____ Ft. from S. Line

330 Ft. from E. Line

_____ Ft. from W. Line

NE NE NE

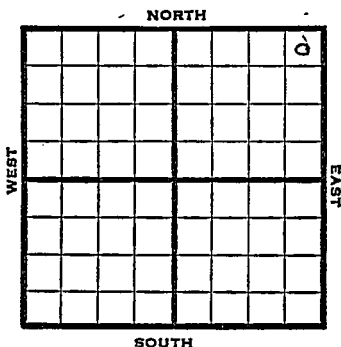

1952

Elev. 1981'

REPORT

1/23

Spud 1220-52
Drlg.

2/6

8" @ 83 Anhy 910.
Topeka 3074 Br Li 3500
Simp 3860
DST 3860-79, 1 1/4 hrs 1500' oil, 1500'
wtr Arb. 3916
TD 3921 Rng pipe.

2/13

5" @ 3918' DP CO to 3921'
S/1 1/2 B sulph wtr 1 hr.
DD 3929' S/6 B sulph wtr. PB

2/20

20/ 3911-14 trace oil set plug 3900
24/ 3861-65 S/ 12 boph & trace
for 8 hrs. POP

3/5

NR

3/12

"

3/19

"

3/25

MICT

4/1

Sq all perfs CO to 3886'
10/3858-59 B/wtr. S/30 BFPH
25% oil To sq.

4/9

9/3876-77 wtr Sq off 9/3858-59 CO

4/23

NR

OVER

1952

4/30

5/7

39 BOPD plus 65% water.
Spud -I-20-52
Oil Well TD 3929 8" @ 833'
Anhy 910 Top 3074
Br Li 3500 Simp. 3858
DST 3860-79 open $1\frac{1}{4}$ hr. rec. 1500'
oil 1500' wtr. Arb. 3916
TD 3921 5" @ 3918 CO to 3921
S/ $1\frac{1}{2}$ bbl. sul. wtr. 1 hr.
DD 3929 S/ 6 bbl. sul. wtr.
PB 20/ 3911-14 SP 3900
24/ 3861-85 S/ 12 boph CO to 3886
10/ 3858-59 B/ wtr. S/ 30 bfph
25% oil 9/ 3876-77 wtr.
9/ 3858-59 Comp. 39 bopd 60% wtr.

COMPLETED

