


Section 2 Township 22 Range 11WWell No. #1 IsernCompany Mallonee Drlg.

NORTH

WEST

EAST

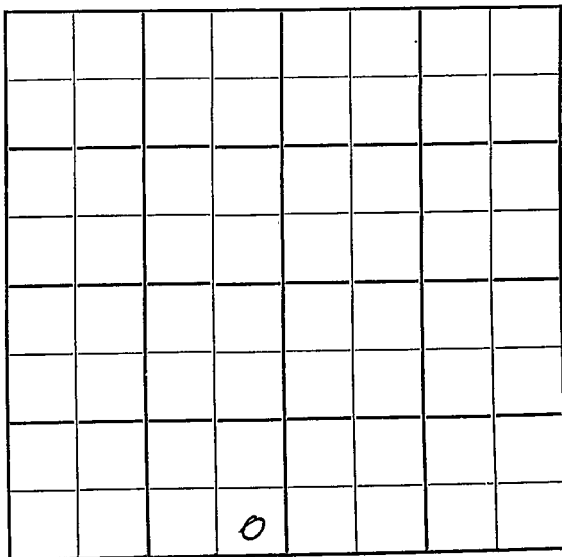

SOUTH

Stafford

KANSAS

Sec. 2 Twp. 22 R. 11 W ✓

Well No. # 1 Isern Farm

Mallonee Drlg. Company

Mallonee Drlg. Contractor

Wildcat


Ft. from N. Line

330 Ft. from S. Line

330 Ft. from E. Line

Ft. from W. Line

SE SE SW

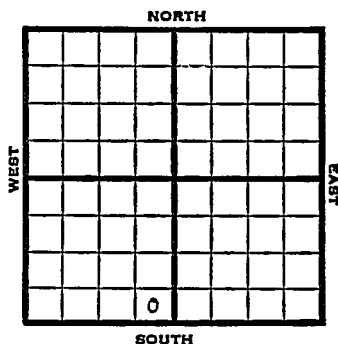


1951 Elev. 1756' REPORT

10/3
10/24

RUR
10-2-51
D&A TD 3579
8" @ 187
Heeb. 2986 Br. lm. 3132
Ians. 3156 Marm. 3434
Cong. 3454 Viola 3460
DST 3462-86 open 45 min.
Rec. 6' mud
Simp. 3479
DST 3538-48 open 1 hr.
Rec. 105' GCM& Wtr.
Arb. 3546
TD 3579
D&A

ABANDONED

County Stafford State Kansas
 Sec. 2 (Blk. 2 2) (Sur. 11W) Map No. 11W
 Operator Mallonee Drlg.
 Well No. 1 Farm Isern
 Elev. 1756 Location SE SE SW

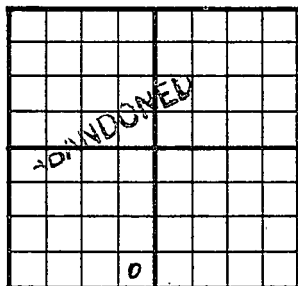

330 Ft. From S Line SW
330 Ft. From E Line Quarter
 Ist. Report
 Completion OCT 24 1951
 Remarks Wildcat
Mallonee Drlg. - Contr.
 Spudding Date 10-2-51

Drlg. Data D & A TD 3579
8" @ 187 Heeb. 2986 Br. lime 3132
Lans. 3156 Marm. 3434 Cong. 3454
Viola 3460 DST 3462-86 open 45 min.
Rec. 6' mud Simp. 3479 DST 3538-48
open 1 hr. Rec. 105' gcm & water
Arb. 3546 TD 3579

D & A

J. E. TYRA