

KANSAS

Stafford

Form 51-5M-7-39-Palace


Section 2 Township 22 Range 12-W

Well No. #5 Hitz

Company Stanolind

Sittner Pool

NORTH

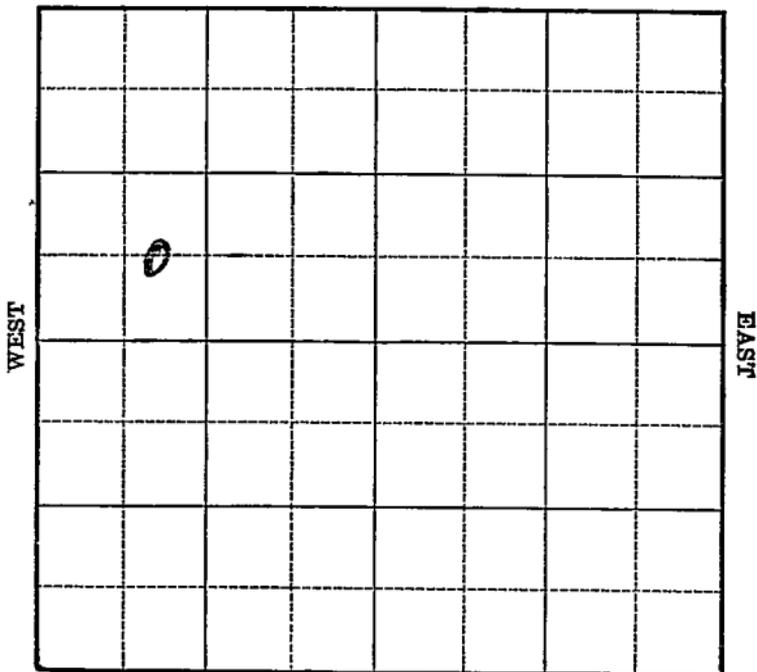

SOUTH

Sec. 2 Twp. 22 R. 12-W

Well No. #5 Hitz Farm

Stanolind Company

(Sittner)


_____ Ft. from N. Line

660 Ft. from S. Line

_____ Ft. from E. Line

990 Ft. from W. Line

Elev. 1836

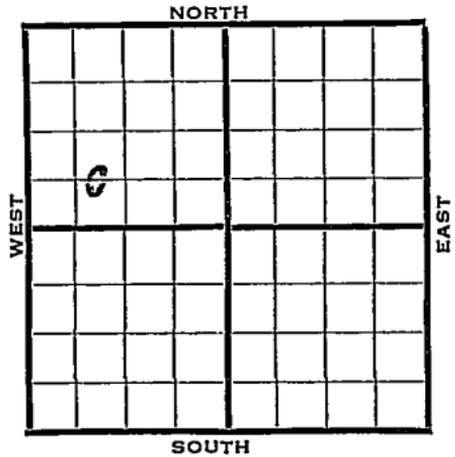

1940	REPORT
5/1	Rotary Derrick.
5/9	8" - 231' WOC.
5/16	Anhy 604' Drlg. 3235'
5/23	Lansing 3258' Viola 3505' Simp. 3536' Arb. 3582½-87½ TD. S.S.O. 5" - 3583' RUST.
5/29	T.D. 3587½' 5000 acid. Flow 13 bbls. per hour.
6/6	Swab 70 bbls. per hour & 4 bb̄s. water.
6/12	Arb. 3582½' 5" - 3583' T.D. 3587½' 5000 acid. Depthograph potential 1710 bbls. oil plus 43% water.
	COMPLETED

Map No. 46 Sec. 2 Twp. 22 R. 12WWell No. 5 HitzStanolind CompanyFIRST REPORT ContractorC $E\frac{1}{2}$ SW NW Ft. from N. Line660 Ft. from S. Line Ft. from E. Line990 Ft. from W. Line

SECTION PLAT

o			

SITTNER POOL

Location Rig up

Drilling and Remarks:

Rotary Derrick

RECORD

Cased in., ft.Sand Gas Oil Total Depth

PRODUCTION

1st 24 hrs. Nat. 1st 24 hrs. after shot Gas Cu. Ft.Dry Hole Abandoned

Date

MAY 1 1940₁₉

S. J. LEWIS Scout

Map No. 46 Sec. 2 Twp. 22 R. 12W

Well No. 5 Hitz

Stanolind Company

Contractor

COMPLETED

SECTION PLAT

C $E\frac{1}{2}$ SW NW

o			

_____ Ft. from N. Line

660 Ft. from S. Line

_____ Ft. from E. Line

990 Ft. from W. Line

SITTNER POOL

Location _____

RECORD

Rig up _____

Cased _____ in., _____ ft.

Drilling and Remarks:

Sand _____

Core 3582 1/2

Gas _____

5" @ 3583

Oil _____

5000 acid

Total Depth 3587 1/2

PRODUCTION

Depthograph 28

1st 24 hrs. Nat. _____

1710 Plus 43% wa

1st 24 hrs. after shot _____

Gas _____ Cu. Ft.

Dry Hole _____

Abandoned _____

Date

JUN 12 1940₁₉

S. J. LEWIS Scout