

Section 2 Township 22 Range 12W

Well No. #1 Hitz

Company Petroleum Inc.

NORTH

			0			.	.

WEST

EAST

SOUTH

Sec. 2 Twp. 22 R. 12W

Well No. #1 Hitz Farm

Petroleum Inc. Company

Garvey Contractor

Max Pool

990 Ft. from N. Line


Ft. from S. Line

330 Ft. from E. Line

Ft. from W. Line

NW 1/4 SE NE NW

Stanolind Farmout

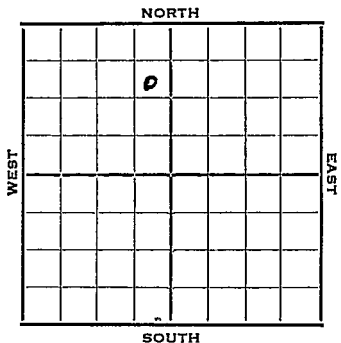

1952	Elev. 1826' REPORT
10/22	Spud 10-15-52 8" @ 225 Anhy 615' Drlg. 3056'
10/29	Heeb 3086, Br li 3217', Lans 3239, V 3499, Simp sha 3537, Arb 3590 RTD 3594 5" @ 3591'
11/5	NR GO DD 3596'
11/12	DD 3598' TD 500 A 3/400 BFPD 50% wtr. POP
11/20	NR
11/27	"
12/4	"
12/11	NR
12/17	Spud 10-15-52 Oil Well TD 3598' 8" @ 225 Anhy 615, Heeb. 3086', Br lime 3217, Lans 3239 DST 3292-3315, opn 1 hr., rec. 30' ocm, 600' frothy oil, 300' clean oil, 810# DST 3358-82, opn 1 hr., rec. 63' ocm, 478' frothy oil, 2' sw

OVER

(Information Brought Forward)

1952

12/17 DST 3386-3420, opn 1 hr., rec.
70' socm, 100' mco, 10' wtr.
1260#

DST 3426-40, opn 40 mins.,
rec. 240' cleanoil 1400#

Viola 3499, Simp. sh. 3537, Arb.
3590

DST 3591-94, opn 1 hr., rec. 120'
gas, 30' so & gcm, 0#

5" @ 3591

TD 3594

CO to 3596

DD 3598 500A

S/400 bfpd 50% wtr.

P/200 bopd 200 bw

Comp. 34 bopd 80% wtr.

COMPLETED

County **Stafford** State **Kansas**

Sec. **2** (Blk. **22**) (Sur. Rge.) **12W** Map No.

Operator **Petroleum Inc.**

Well No. **I** Farm **Hitz**

Elev. Location **SE NE NW**

		0			
FIRST REPORT					

990 Ft. From **N** Line **NW**

330 Ft. From **E** Line **Quarter**

Ist. Report **OCT 22 1952**

Completion

Remarks **Stanolind farmout**

Garvey - Contr.

Spudding Date **10-15-52**

Drlg. Data **Max Pool**

8" @ 225 Anhy 615 drlg. 3056

County Stafford State Kansas
 Sec. 2 (Blk. 22) (Sur. 12W) Map No. 12W
 Operator Petroleum Inc.
 Well No. 1 Farm Hitz
 Elev. 1826 Location SE NE NW

990 Ft. From N Line NW
330 Ft. From E Line Quarter
 Ist. Report
 Completion DEC 17 1957
 Remarks Max Pool
Garvey - Contr.
 Spudding Date 10-15-52

COMPLETE

Drlg. Data Oil well TD 3598
8" @ 225 Anhy 615 Heeb. 3086
Br. line 3217 Lans. 3239 DST 3292-3315
open 1 hr. Rec. 30' ocm 600' frothy oil
300' clean oil 810# DST 3358-82
open 1 hr. Rec. 63' ocm 478' frothy oil
2' sw DST 3386-3420 open 1 hr. Rec.
70' socm 100' mco 10' wtr. 1260#
DST 3426-40 open 40 min. Rec. 2040'
clean oil 1400# - Viola 3499
Simp. sh. 3537 Arb. 3590 DST 3591-94
open 1 hr. Rec. 120' gas --30' so & gcm
0# 5" @ 3591 TD 3594 CO to 3596
DD 3598 500 A S/ 400 bfpd 50% wtr.

DEC 30 1952

Scout Cards
Land Small Map
Land Wall Map
Tracings
France Map
Pierre Map
Misc.

[Handwritten signature]
[Handwritten mark]

Comp. 34 bopd

F / 200 bopd 200 bw

80% wtr.

Dirg. Data