


Section 2 Township 22 Range 12-W

Well No. #2 Hitz

Company Stanolind

NORTH **Sittner Pool**

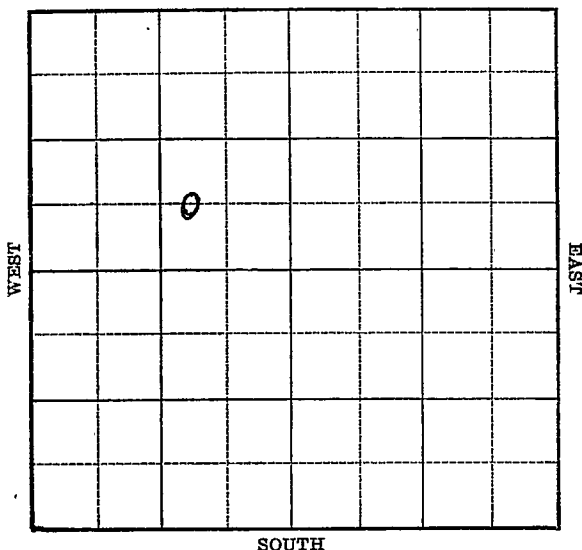

Map No. 46 Sec. 2 Twp. 22 R. 12WWell No. 2 HitzStanolind

Company

Contractor

FIRST REPORT**C W $\frac{1}{2}$ SE NW****SECTION PLAT**

	0		

_____ Ft. from N. Line

660 Ft. from S. Line

_____ Ft. from E. Line

1680 Ft. from W. Line**SITTNER POOL**

Location _____

Rig up _____

Drilling and Remarks: ?

Derrick**RECORD**

Cased _____ in., _____ ft.

Sand _____

Gas _____

Oil _____

Total Depth _____

PRODUCTION

1st 24 hrs. Nat. _____

1st 24 hrs. after shot _____

Gas _____ Cu. Ft.

Dry Hole _____

Abandoned _____

Date

NOV 8 1929 19

S.

T.M.S.

Scout

Stafford KANSAS


Map No. 46 Sec. 2 Twp. 22 R. 12WWell No. 2 HitzStanolind

Company

Contractor

COMPLETED
C $W\frac{1}{2}$ SE SW

SECTION PLAT

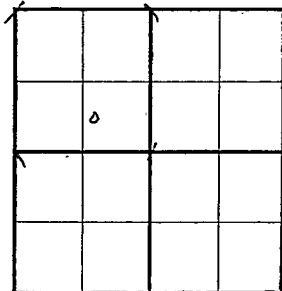 Ft. from N. Line660 Ft. from S. Line Ft. from E. Line1680 Ft. from W. Line

SITTNER POOL

Location Rig up

Drilling and Remarks:

*Cr 83566**5" @ 3566**1000 acid**Depth graph P&S**253 lb**Maximum 3000*

RECORD

Cased in., ft.Sand Gas Oil Total Depth 3571

PRODUCTION

1st 24 hrs. Nat. 1st 24 hrs. after shot Gas Cu. Ft.Dry Hole Abandoned

Date

DEC 13 1939 19

S. J. LEWIS

Scout