

Section 2 Township 22 Range 12WWell No. #7 Hitz "A"Company Stanolind Oil & Gas

NORTH

			0				

WEST

EAST

SOUTH

Stafford

KANSAS

Sec. 2 Twp. 22 R. 12WWell No. #7 Hitz "A" Farm

Stanolind Oil & Gas

Company

Prime Drlg.

Contractor


Heyen Pool

Ft. from N. Line

990 Ft. from S. Line330 Ft. from E. Line

Ft. from W. Line

NE SE NW

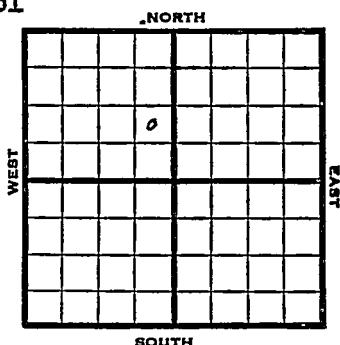

1953 Elev. 1826' REPORT

7/14 MIRT

7/22 8" @ 162 w/400

Anhy 604

Drlg. 3318'

7/29 Lans 3242'

DST 3298-3318, 1 hr, 340' SW 1140#

DST 3361-84, 1 hr, 105' M 1150#

DST 3384-3415, 1/2 hr, 28' M

DST 3428-43, 1 hr, 150' MCO 860#

Arb. 3627' RTD 3660 5" @ 3629

8/5 GO Testing

8/12 Spud 7-13-53

Oil Well

TD 3660'

8" @ 612'

Anhy 604, Lans 3242

DST 3298-3318 opn 1 hr, rec 340' sw, 1140#

DST 3361-84 opn 1 hr, rec 105' mud, 1150#

DST 3384-3415 opn 1/2 hr, rec 28' mud 0#

DST 3428-43 opn 1 hr, rec 150' mco 860# Arb 3627

TD 3660'

5" @ 3629'

OVER

1953

Information brought forward.

8/12 CO to 3597:
20/ 3442-47 500 A $11\frac{1}{2}$ bo 1 hr.
dec. to $1\frac{1}{2}$ bo S/ 3 bfp 16 hr.
40% wtr.
33/ 3452-60 A-frac S/ $1\frac{1}{4}$ bo 4 bw
12 hr.
Comp. 44 bopd. 60% wtr.

COMPLETED

County **Stafford** State **Kansas**

Sec. 2 (Blk. 22) (Sur. 12W) Map No. _____

Operator Stanolind Oil & Gas

Well No. 7 Farm Hitz "A"

Elev.	Location	NE	SE	NW
-------	----------	----	----	----

0

FIRST REPORT

990 Ft. From S Line NW

330 Ft. From R Line Quarter

1st. Report JUL 14 1953

Completion

Remarks


Prime Drlg. - Contr.

Spudding Date _____

Drig. Data Heyen pool

MIRT

J. G. McGEHEE

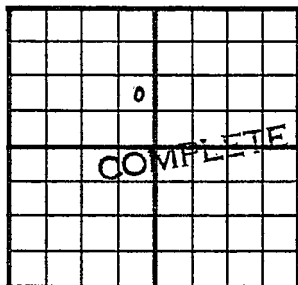County Stafford State KansasSec. 2 (Blk.) 22 (Sur.) 12W Map No.Operator StanolindWell No. 7 Farm Hitz "A"Elev. 1826 Location NE SE NW990 Ft. From S Line NW330 Ft. From E Line Quarter

1st. Report

Completion AUG 12 1953Remarks Heaven PoolPrime Drlg. - Contr.Spudding Date 7-13-53Drlg. Data Oil well TD 36608" @ 612 Anhy 604 Lans. 3242 DST 3298-3318 open 1 hr. Rec. 340' sw 1140#DST 3361-84 open 1 hr. Rec. 105' mud1150# DST 3384-3415 open 1/2 hr. Rec.28' mud 0# DST 3428-43 open 1 hr.Rec. 150' mco 860# Arb. 3627TD 3660 5" @ 3629 CO to 359720/ 3442-47 500 A 11 1/2 bo 1 hr.dec. to 1 1/2 bo S/ 3 bfph 16 hr. 40% wtr.33/ 3452-60 A-frac S/ 1 1/4 bo 4 bw 12 hr.Comp. 44 bopd 60% wtr.

J. G. McGEHEE