

# KANSAS


Stafford

Section 2 Township 22 Range 12W

Well No. 1 Krug

Company Petroleum Inc.

Sittner  
NORTH

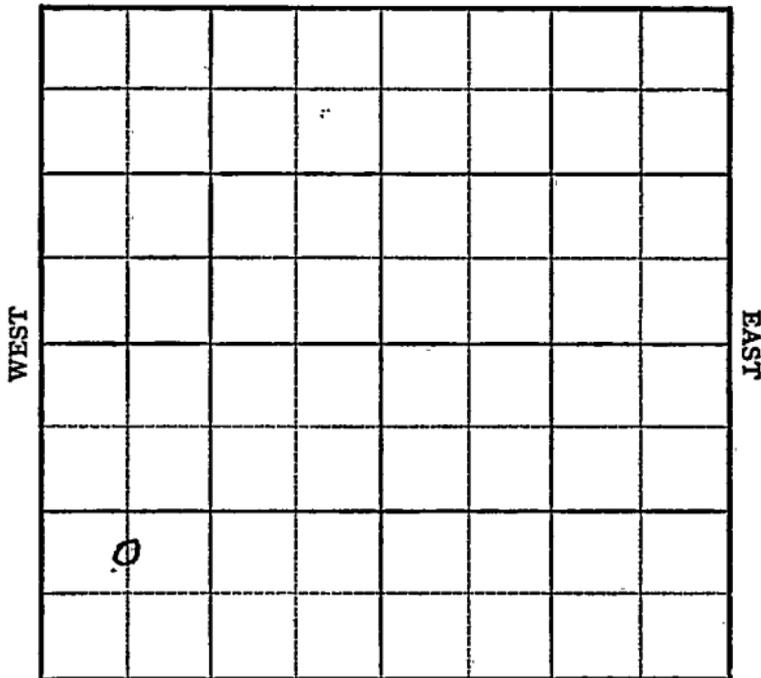

SOUTH

**KANSAS**

Stafford

Sec. 2 Twp. 22 R. 12W ✓

Well No. #1 Krug Farm \_\_\_\_\_  
 \_\_\_\_\_  
 Petroleum, Inc. Company \_\_\_\_\_

**Sittner Pool**


\_\_\_\_\_ Ft. from N. Line

990' Ft. from S. Line

\_\_\_\_\_ Ft. from E. Line

660' Ft. from W. Line

**C N L SW SW**

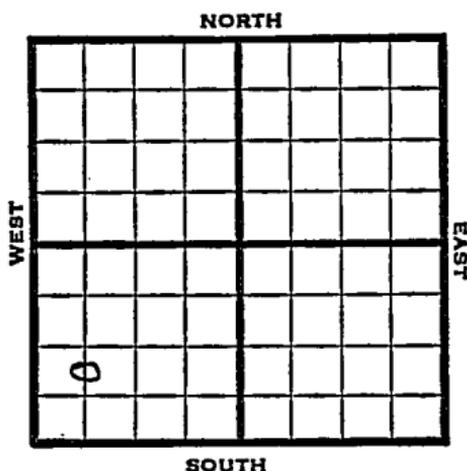

1949

**Elev. 1837' REPORT**

2/16

RUR

2/23

8" @ 250'  
Drlg. 2600'

3/2

Lansing 3279'  
Viola 3544'  
Simpson 3583'  
Arbuckle 3633'  
TD 3649'  
5" @ 3634'

3/8

"

3/16

2750 acid 10 W - PH

3/23

Squeeze

3/30

Arb 3633'  
5" @ 3634'  
TD 3649'

**ABANDONED**

Map No. \_\_\_\_\_ Sec. 2 Twp. 22 R. 12W

Well No. 1 Krug

Petroleum Inc. Company

FIRST REPORT Contractor

C N L SW SW

**SECTION PLAT**

\_\_\_\_\_ Ft. from N. Line

990 Ft. from S. Line

\_\_\_\_\_ Ft. from E. Line

660 Ft. from W. Line


Stafford County

Location \_\_\_\_\_

Rig up \_\_\_\_\_

Drilling and Remarks:

R U R

**RECORD**

Cased \_\_\_\_\_ in., \_\_\_\_\_ ft.

Sand \_\_\_\_\_

Gas \_\_\_\_\_

Oil \_\_\_\_\_

Total Depth \_\_\_\_\_

**PRODUCTION**

1st 24 hrs. Nat. \_\_\_\_\_

1st 24 hrs. after shot \_\_\_\_\_

Gas \_\_\_\_\_ Cu. Ft.

Dry Hole \_\_\_\_\_

Abandoned \_\_\_\_\_

Date

FEB 16 1940 19

S. J. LEWIS

Scout

