

Section 2 Township 22 Range 12WWell No. #1 Tiechman "A"Company Lindas Oil

NORTH

WEST

EAST

				o			

SOUTH

Stafford

~~KANSAS~~

Sec. 2 Twp. 22 R. 12W

Well No. #1 Tiechman "A" Farm

Lindas Oil Company

Max Pool Contractor


330' Ft. from N. Line

Ft. from S. Line

Ft. from E. Line

330' Ft. from W. Line

NW NW NE

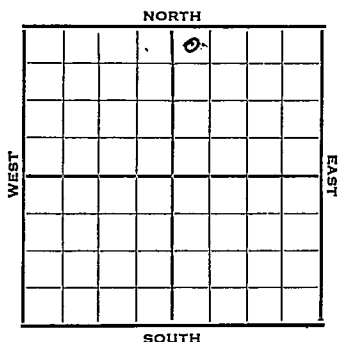

1951

Elev. 1827' REPORT

11/21

Spud 11-13-51
8" @ 192
Anhy 600
Heeb. 3095
Br Lime 3226
Lans. 3242
Drlg. 3380'

1952
1/16

Spud 11-13-51
Oil well TD 3596' 8" @ 192
Anhy 600' Heeb 3095' Br. lime 3226
Lans. 3242' Viola 3507' Cherty
Viola 3510' Simp. 3541'
DST 3510-43 open $\frac{1}{2}$ hr. rec 30' mud
Arb. 3591' TD 3594' 5" @ 3593
DD 3596' S/2 BOPH 250 A
Comp. 25 BOPD

COMPLETED

County Stafford State KansasSec. 2 (Blk. Twp.) 22 (Sur. Rge.) 12W Map No.Operator Lindas OilWell No. 1 Farm Tiechman "A"Elev. Location NW NW NE

				0		

330 Ft. From N Line NE330 Ft. From W Line Quarter1st. Report NOV 21 1951

Completion

Remarks

Spudding Date 11-13-51Drlg. Data Max Pool8" @ 192 Anhy 600 Heeb. 3095Br. lime 3226 Lens. 3242 drlg. 3380



Operator Lindas Oil

Well No. 1 Farm Tiechman "A"

Elev.	1827	Location	NW NW NE
-------	------	----------	----------

330Ft. From N Line NE

330 Ft. From W Line Quarter

1st. Report

Completion JAN 16 1952

Remarks	Max Pool
---------	----------

Spudding Date 11-13-51

Drig. Data Oil well TD 3596

8" @ 192 Anhy 600 Heeb. 3095

Br. lime 3226 Lans. 3242 Viola 3507

Cherty Viola 3510 Simp. 3541

DST 3510-43 open $\frac{1}{2}$ hr. Rec. 30' mud

Arb. 3591 TD 3594 5" @ 3593 DD 3596

S/ 2 boph 250 A Comp. 25 bopd

J. E. TYRA