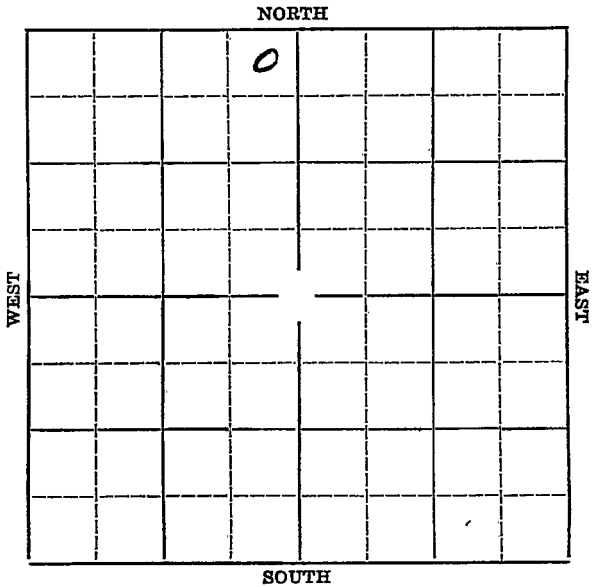


Section 2 Township 22 Range 2-WWell Number 1-KufmanCompany Phillips Pet.

Map No. **KANSAS** Sec. **2** Twp. **22** R. **2W**

Well No. **#1 Kufman** Farm

**Phillips Pet.** Company


**330'** Ft. from N. Line

Ft. from S. Line

**330'** Ft. from E. Line

Ft. from W. Line

Elev. 1474

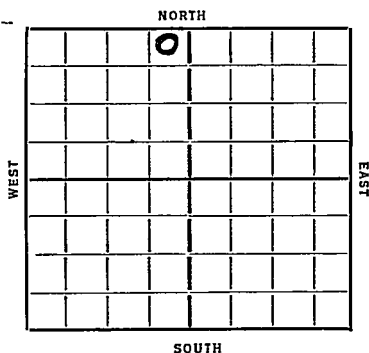

Date **1936**

REPORT

**6/17** Building rig.

**6/25** 161'. Waiting on cement.

**7/2** K.C. 2360'. Drlg. 2425'.

**7/9** Chat 2990'. B. Miss. L. 3327'.

8" @ 3358'. RUST.

**7/16** --

**7/22/36**-Hole full of water 3439-46'.

T.D. 3453'.

D & A

ABANDONED

Map No. 43 Sec. 2 Twp. 22 R. 2W

Well No. 1 Hayman

Phillips P. & S. Company

Contractor

## SECTION PLAT

|  |  |   |  |  |
|--|--|---|--|--|
|  |  | 0 |  |  |
|  |  |   |  |  |
|  |  |   |  |  |
|  |  |   |  |  |
|  |  |   |  |  |

380 Ft. from N. Line

\_\_\_\_\_ Ft. from S. Line

390 Ft. from E. Line

\_\_\_\_\_ Ft. from W. Line

## FIRST REPORT

Location \_\_\_\_\_

Rig up \_\_\_\_\_

Drilling and Remarks:

*Building rig*

## RECORD

Cased \_\_\_\_\_ in., \_\_\_\_\_ ft.

Sand \_\_\_\_\_

Gas \_\_\_\_\_

Oil \_\_\_\_\_

Total Depth \_\_\_\_\_

## PRODUCTION

1st 24 hrs. Nat. \_\_\_\_\_

1st 24 hrs. after shot \_\_\_\_\_

Gas \_\_\_\_\_ Cu. Ft.

Dry Hole \_\_\_\_\_

Abandoned \_\_\_\_\_

Date

JUN 17 1936<sub>19</sub>

S. J. LEWIS

Scout

KANSAS

Map No. 43 Sec. 2 Twp. 22 R. 2WWell No. 1 KaufmanPhillips Company

Contractor

## SECTION PLAT

|  |  |   |  |
|--|--|---|--|
|  |  | 0 |  |
|  |  |   |  |
|  |  |   |  |
|  |  |   |  |

330 Ft. from N. Line

\_\_\_\_\_ Ft. from S. Line

330 Ft. from E. Line

\_\_\_\_\_ Ft. from W. Line

ABANDONED

Location \_\_\_\_\_

Rig up \_\_\_\_\_

Drilling and Remarks:

HFW 3439-46.

DHA

## RECORD

Cased \_\_\_\_\_ in., \_\_\_\_\_ ft.

Sand \_\_\_\_\_

Gas \_\_\_\_\_

Oil \_\_\_\_\_

Total Depth: 3453

## PRODUCTION

1st 24 hrs. Nat. \_\_\_\_\_

1st 24 hrs. after shot \_\_\_\_\_

Gas \_\_\_\_\_ Cu. Ft.

Dry Hole \_\_\_\_\_

Abandoned \_\_\_\_\_

Date

JUL 22 1936

19

S. J. LEWIS

Scout