

Section 20 Township 22 Range 13 W

Well No. # 1 Soeken

Company M. B. Armer

NORTH

WEST	0							
	1							
	i							

EAST

SOUTH

Sec. 20 Twp. 22 R. 13W

Well No. #1 Soeken Farm

M. B. Armer Company

Armer Contractor


330 Ft. from N. Line

_____ Ft. from S. Line

_____ Ft. from E. Line

330 Ft. from W. Line

NW NW NW
Sohio \$2500 DHM

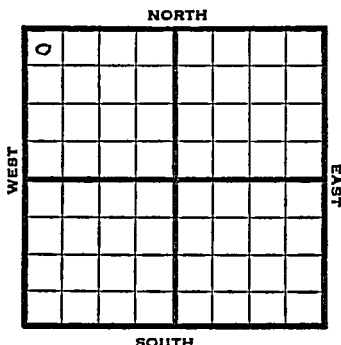

1952 Elev. 1909 REPORT

9/4 MIM
9/10 8" @ 332 Drlg. 1986
9/17 Heeb. 3297 Br Li 3426
Lans. 3447
DST 3584-3612, 1 hr. 95'm 1150#
DST 3637-51, 1 hr. 300' O&GCM
900' wtr. 1139# SIMP. 3802
Drlg. 3806'
9/24 Spud 9-5-52 D&A TD 3901
8" @ 332 Heeb. 3297 Br Lime 3426
Lans. 3447 DST 3584-3612 opn 1 hr.
Rec. 95' mud 1150# DST 3637-51
opn 1 hr. Rec. 300' o & gcm 900' wtr.
1139# Simp 3802 Arb. 3852
TD 3901 D&A

ABANDONED

County Stafford State KansasSec. 20 (Blk. Twp.) 22 (Sur. Rge.) 13W Map No.Operator M. B. ArmerWell No. 1 Farm SoekenElev. Location NW NW NW

0							

FIRST REPORT

330 Ft. From N Line NW330 Ft. From W Line Quarter1st. Report SEP 4 1952

Completion


Remarks Sohio \$2500 DHMArmer - Contr.

Spudding Date

Drig. Data

M I N

J. G. McGEHEE

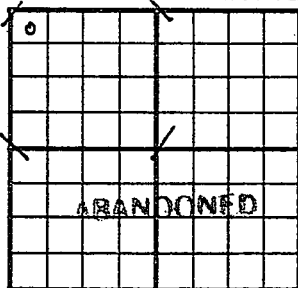County Stafford State KansasSec. 20 (Blk. Twp.) 22 (Sur. Rge.) 13W Map No.Operator M. B. ArmerWell No. 1 Farm SoekenElev. 1909 Location NW NW NW330 Ft. From N Line NW330 Ft. From W Line Quarter1st. ReportCompletion SEP 24 1952RemarksArmer - Contr.Spudding Date 9-5-52Drlg. Data D & A TD 39018" @ 332 Heeb. 3297 Br. lime 3426Lans. 3447 DST 3584-3612 open 1 hr.Rec. 95' mud 1150# DST 3637-51open 1 hr. Rec. 300' o & gcm 900' wtr.1139# Simp. 3802 Arb. 3852 TD 3901D & A

J. G. McGEHEE