

Stafford


KANSAS

SECTION 20 TOWNSHIP 22 RANGE 14 W

WELL NO. #1 Sutton

COMPANY F. B. Anschutz

NORTH

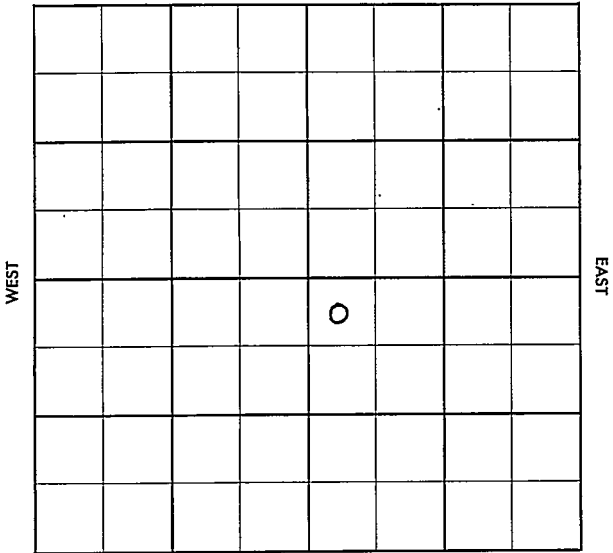

SOUTH

SEC.	TWP.	R.
20	22 S	14 W
WELL NO.		
#1 Sutton FARM		
COMPANY F. B. Anschutz		
CONTRACTOR Wayne Pritchard		

Co. tools

• Wildcat

_____ Ft. from N. Line

_____ Ft. from S. Line


_____ Ft. from E. Line

_____ Ft. from W. Line

NW NW SE

SDX DHC \$2,500.00

Lse. (S-27692A & S-10749)

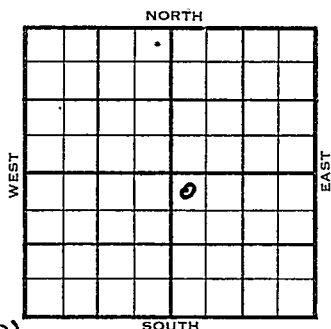

	ELEVATION	REPORT
1955	1953'	(WH5-DC65)
9/22	Arbuckle formation test Approx 4000' To be commenced by October 10, 1955 To be completed by December 1, 1955 (See DHC Ltr. 8-30-55)	
10/10	Amendment for the extension of the commencement date to November 25, 1955, and the completion date to January 10, 1956. (See DHC Ltr. 10-10-55)	
11/2	Comm. 10-30-55 8" @ 263/100 Drlg. 2155' (F.R. Tkt)	
11-10	DST 3644-52, op 1 hr. rec 5' mud, 0# Cong. 3842, Viola 3897, Sipp. 3940 DST 3956-82, op 1 hr. rec. 15' rotary mud, 0/20", Arb 4000 Drlg. 4008	
11/16	Comm. 10-30-55 8" @ 263/100 DST 3644-52, open 1 hr rec 5' mud. 0# DST 3956-82 open 1 hr rec 15' rotary mud. 0/20". D & A. TD 4033'	

OVER

1955

11/16

(Information continued)

Tops: Anh. 878', H. 3385', BL 3517'
L. 3526', C. 3842', V. ch. 3897',
~~XXXXXX~~ Sh 3940', Arb. 4003'

Log: H. 3386', BL 3519', L. 3527',
BKC 3760', C 3844', V. ch 3899',
V. 1m 3920', Sh 3942', Simp sd. 3956',
Arb. 4003'

TD 4033' D & A

ABANDONED

11/25 Advised Contract Section= D & A

County

Stafford

Elev.

Sec.

20

Twp.

(22)

Rge.

14W

Company

F. B. Anschutz

Farm Name

Sutton

No.

1

TOPS ✓

DEPTH

LOG

DATUM

Loc. in Sec.

NW NW SE

Anh.

Tp.

H.

Tr.

Dg.

BL.

L.

K.C.

B.K.C.

Ce.

C.

M.

M.

K.

Mz.

Ma.

V.

S.

S.

A.

R.

PE.

G.

T.D.


Geol.

Contr.

Co. tools

Pool

Wildcat

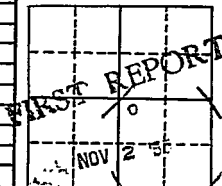

Date Comm.

10-30-55

Sunray, MCOC - DNM

8" @ 263/100 drlg. 2155

13

County Stafford Elev. 1953
 Sec. 20 Twp. (22) Rge. 14W
 Company F. B. Anschutz
 Farm Name Sutton No. 1

TOPS	DEPTH	LOG	DATUM
Anh.	878		
Tp.			
H.	3385	3386	1433
Tr.			
Dg.			
Bl.	3517	3519	1566
L.	3524	3527	1574
K.C.			
B.K.C.		3760	1817
Ce.			
C.	3842	3844	1891
M.			
M.			
K.			
Mz.			
Mo.			
V. Ch.	3897	3899	1946
S. Vin/21m		3930	1967
S. Sh	3940	3942	1989
A. Sinner		3956	2003
R. Anh.	4003	4003	2050
Pe.			
G.			
T.D.	4033		

Loc. in Sec. _____

NW NW SE


Geol. _____

Contr. _____

Co. tools

Pool

Wildcat

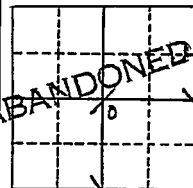Date Comm. 10-30-55

NOV 16 1955

8" @ 263/100 DST 3644-52 open 1 hr.

Rec. 5' mud 0# DST 3956-82 open

1 hr. rec. 15' rotary mud 0/20"

D & A