


KANSAS Stafford

Section 20 Township 22 Range 11W

Well No. #1 C Aiken

Company Continental

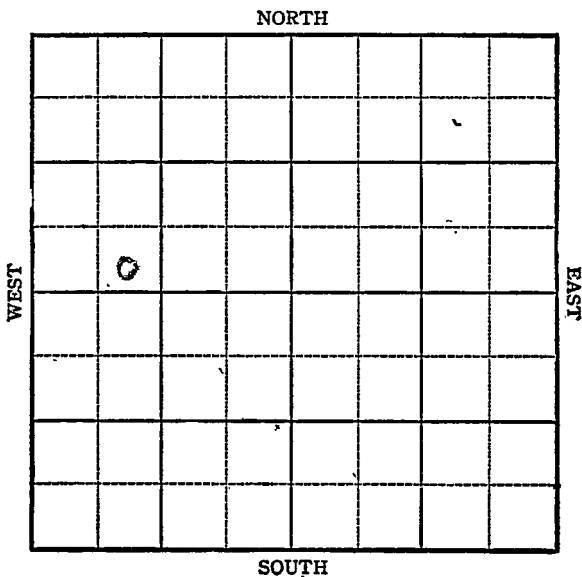

Sec. KANSAS Twp. Stafford
22 R. 11W

Well No. #1 C Aiken Farm
Continental Company

Richardson


_____ Ft. from N. Line

330 Ft. from S. Line

_____ Ft. from E. Line

990 Ft. from W. Line

See 1837

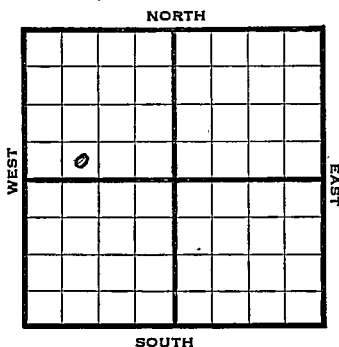

1944

REPORT

7/26	Location
8/2	"
8/9	"
8/16	"
8/23	"
8/30	"
9/8	RUR
9/13	10" @ 280'
	Drig. 3190
9/21	Drig. 3530
9/28	Arb 3557
	TD 3562- 6" @ 3558 RUST
10/4	TD 3586 15 gals. oil per hr.
10/11	TD 3720 swb 18 oil in 8 hrs.
10/18	500 acid swb 20 oil in 5 hrs.
10/25	92' of 4" liner @ 3720
	500 acid swb 20 oil in 7 hrs.
11/1	" " " " " " " "
11/8	" " " " " " " "
11/16	" " " " " " " "
11/24	" " " " " " " "
11/29	" " " " " " " "
12/6	" " " " " " " "
12/14	" " " " " " " "
12/21	" " " " " " " "
12/29	" " " " " " " "
1945	
1/3	" " " " " " " "

OVER

1945
1/10 2000 oil in 24 hrs
1/17 " " " " "

1/24 Lans. 3251
Arb. 3557
6" @ 3558
TD 3730
92' of 4" liner on bottom
500 acid.
Pump 99 Pot.
Grav. 41.0

COMPLETED

Pool Name Richardson

Map No. KANSAS 20 Sec. 20 Twp. 22 R. 11W


Well No. 1 C. Aiken

Continental Company

FIRST REPORT Contractor

SE SW NW

SECTION PLAT

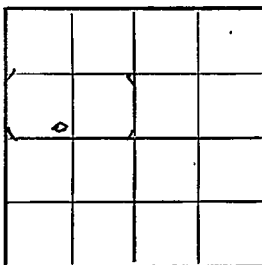

_____ Ft. from N. Line

330 Ft. from S. Line

_____ Ft. from E. Line

990 Ft. from W. Line

Stafford County

Location X

Rig up _____

Drilling and Remarks:

RECORD

Cased _____ in., _____ ft.

Sand _____

Gas _____

Oil _____

Total Depth _____

PRODUCTION

1st 24 hrs. Nat. _____

1st 24 hrs. after shot _____

Gas _____ Cu. Ft.

Dry Hole _____

Abandoned _____

Date

JUL 26 1944 19

S. J. LEWIS Scout

Pool Name RichardsonMap No. K-46 Sec. 20 Twp. 22 R. 11WWell No. 1 C. AikenContinental

Company

COMPLETED

Contractor

SE SW NW

SECTION PLAT

_____ Ft. from N. Line

330 Ft. from S. Line

_____ Ft. from E. Line

990 Ft. from W. LineStafford

Location _____

Rig up _____

Drilling and Remarks:

L 325CR 3556" 35592' 7/4" wire on to the500 acidProd 99 ProdDate 4-2-45

RECORD

Cased _____ in., _____ ft.

Sand _____

Gas _____

Oil _____

Total Depth 3720

PRODUCTION

1st 24 hrs. Nat. _____

1st 24 hrs. after shot _____

Gas _____ Cu. Ft.

Dry Hole _____

Abandoned _____

JAN 24 1945 19

S. J. LEWIS Scout