


Section 20 Township 22 Range 11 W
Well No. # 2 Aiken "A"
Company Mallard Drlg.

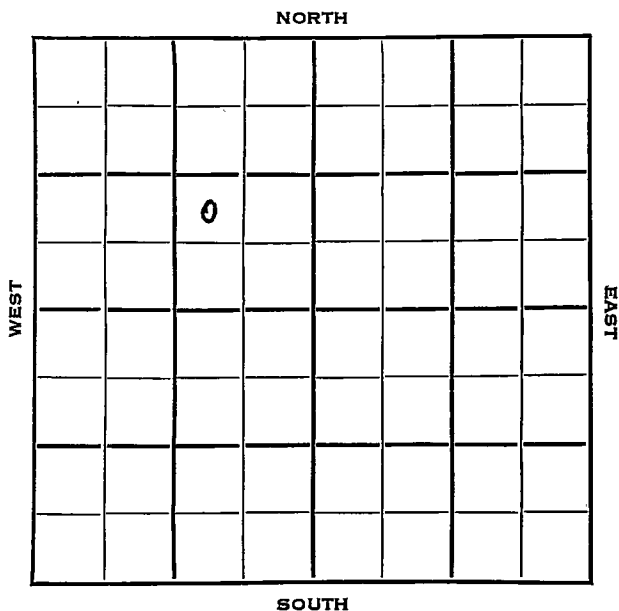

Sec. 20 Twp. 22 R. 11W

Well No. #2 Aiken "A" Farm

Mallard Drlg. Company

Mallard Drlg. Contractor

Richardson Pool


 Ft. from N. Line

990 Ft. from S. Line

990 Ft. from E. Line

 Ft. from W. Line

NW SE NW

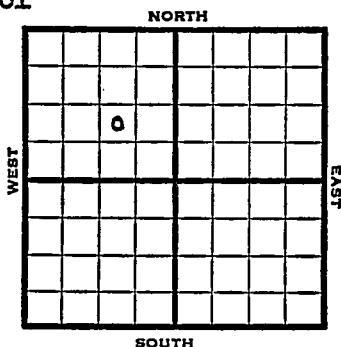

1953 Elev. 1828' REPORT

5/20 MIR

5/28 8" @ 194'
Drlg 3000'

6/3 Arb 3569
RTD 3640'

6/10 36/3600-3606, 1 BOPH 1000 A
5 BOPH G. 42

6/24 Spud 5-20-53 Oil well TD 3640
8" @ 194 Br. line 3225 KC 3253
Simp. 3530 Arb. 3569 TD 3640
5" @ 3640 36/3600-06 1 BOPH
1000 A 5 BOPH
Comp. 252 BOPD

COMPLETED

County Stafford State Kansas
 Sec. 20 (Blk. Twp.) 22 (Sur. Rge.) 11W Map No.

Operator Mallard Drlg.

Well No. 2 Farm Aiken "A"

Elev. Location NW SE NW

FIRST REPORT

990 Ft. From S Line NW

990 Ft. From E Line Quarter

1st. Report MAY 20 1953

Completion

Remarks


Mallard Drlg. - Contr.

Spudding Date

Drig. Data Richardson Pool

M I R

County Stafford State Kansas
 Sec. 20 (Blk. 22 (Sur. 11W Map No.
 (Twp. (Rge.
 Operator Mallard Drlg.
 Well No. 2 Farm Aiken "A"
 Elev. 1828 Location NW SE NW

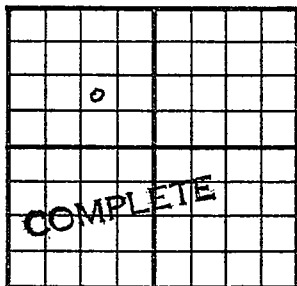

990 Ft. From S Line NW
990 Ft. From E Line Quarter

1st. Report

Completion JUN 24 1953

Remarks Richardson Pool

Mallard Drlg. - Contr.

Spudding Date 5-20-53

Drig. Data Oil well TD 3640

8" @ 194 ABb. line 3225 KC 3253

Simp. 3530 Arb. 3569 TD 3640

5" @ 3640 36/ 3600-06 1 boph 1000 A

5 boph Comp. 252 bopd

J. G. McGEHEE