

Stafford


FORM 51

KANSAS

Section 20 Township 22 Range 11W

Well No. #4 McNickle

Company Mallard Drlg.

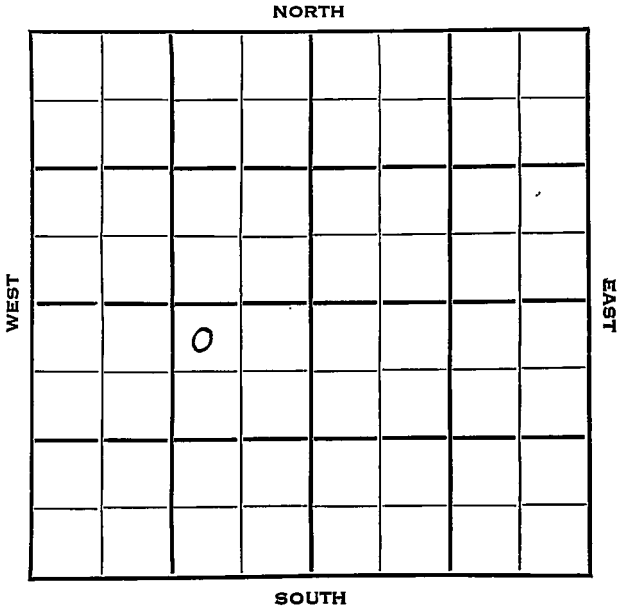

Stafford

KANSAS

SEC.	TWP.	R.
20	22	11W ✓

WELL NO.

4 McNickle

FARM

COMPANY

Mallard Drlg.

CONTRACTOR

Mallard Drlg.

Richardson Pool


330 Ft. from N. Line

Ft. from S. Line

990 Ft. from E. Line

Ft. from W. Line

NW NE SW

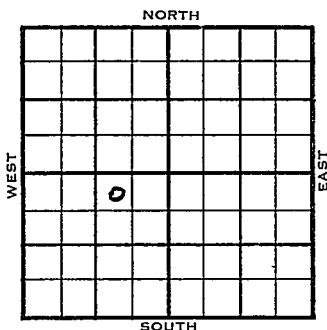

1953

ELEVATION

1835'

REPORT

9/30

Spud 9-27-53

8" @ 184'

Drlg. 1400'

10/7

Br. L. 3286, Lans 3267

Drlg 3590'

10/14

Spud 9-27-53 D & A TD 3637

8" @ 184 Br. line 3236 Lans 3267

Cong. 3534' TD 3637

D & A

ABANDONED

County **Stafford** State **Kansas**

Sec. 20 (Blk. Twp.) 22 (Sur. Rge.) 11W Map No.

Operator **Mallard Drig.**

Well No. 4 Farm McNickle

Elev.	Location	NW DE SW
-------	----------	----------

0

FIRST REPORT

330 Ft. From N Line SW

990 Ft. From E Line Quarter

1st. Report SEP 30 1953

Completion

Remarks

Mallard Brig. - Contr.

Spudding Date **9-27-53**

Drig. Data Richardson Pool

8" @ 184 drlg. 1400

