

Stafford


DX 78-1

KANSAS

Section 20 Township 22 Range 11W

Well No. #1 Hathaway

Company F. Raymond

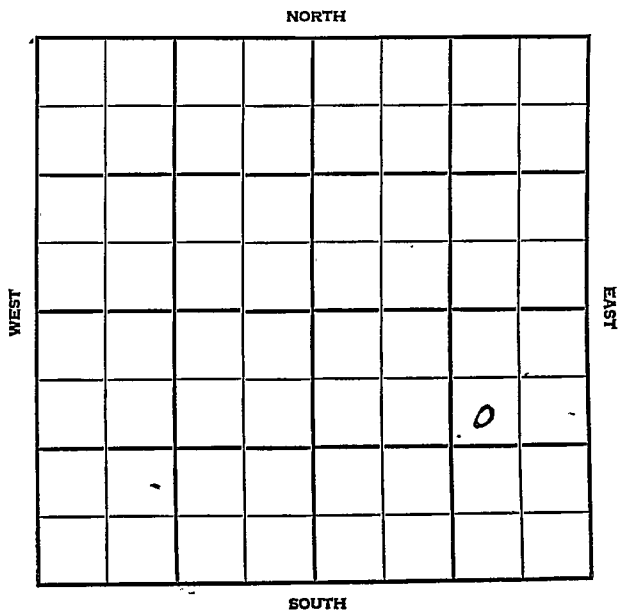

SEC.	TWP.	R.
20	22	11W

WELL NO.

#1 Hathaway

FARM

COMPANY

F. Raymond

CONTRACTOR

Trans-Era

Richardson


_____ Ft. from N. Line

_____ Ft. from S. Line

_____ Ft. from E. Line

_____ Ft. from W. Line

SW NE SE

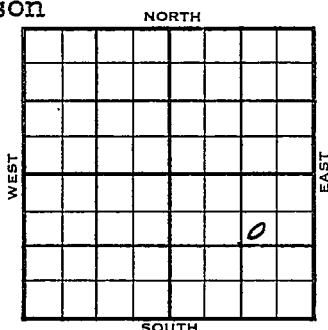

1956	ELEVATION 1841 KB	REPORT
5-9	Comm. 5-7-56 8" @ 228 w/200 WOC	
5-23	Cg. 3539 Vio. 3549', Sp. sh 3560' DST 3551-66-, op 1 hr. g to S., 37" ga., 170 MCF in 10" ga, 134 mcf in 20", ga 109' MCF in 25", rec 48' GCM BHP 1230/' 20" FP 60-80; BHP 1230/20" 1 Arb. 3607' RTD 3610 5 $\frac{1}{2}$ " @2608 w/70	
5-29	CO DD 3632 \$ 5 boph, no/wtr; 8 hr, decreased to 1 bfph	
6-6	DD 3666 TD No increase PB 3621 SF 4/3 \$ L; \$ 12 bfph / 50% wtr.	
6-13	No report	
6-20	P/ 15 bopd / 80 bwpd H. 3101', B.L. 3240', L. 3265', C. 3539', V. 3549', Sh. 3560', TD 3608'	
		COMPLETED

County Stafford Elev. _____
Sec. 20 Twp. 22 Rge. 11W
Company F. Raymond
FarmName Hathaway No. 1

TOPS	DEPTH	LOG	DATUM	Loc. in Sec.
Anb.				SW NE SE
Tr.				
H.				
Tr.				
Dg.				
Bl.				
L.				Geol.
K.C.				Contr.
B.K.C.				Trans-Era
Ce.				
C.				Pool
M.				Richardson
M.				
K.				
Mz.				
Mo.				
V.				
S.				
S.				
A.				
R.				
PE.				
G.				
T.D.				

FIRST REPORT
MAY 9 1956

Date Comm. 5-7-56
8" @ 228/200 WOC

2201 4 I YAM

County Stafford Elev. 1841 KB
 Sec. 20 Twp. 22 Rge. 11W
 Company F. Raymond
 Farm Name Hathaway No. 1

TOPS	DEPTH	LOG	DATUM	Loc. in Sec.
Anh.				SW NE SE
Tr.				
H.	3101			
Tr.				
Dg.				
BL.	3240			
L.	3265			Geol.
K.C.				Contr.
B.K.C.				Trans-Era
Ce.	3539			Pool
C.				Richardson
M.				
M.				
K.				
Mz.				
Ma.				
V.	3549			
S.	sh 3560			
S.				
A.	3607			
R.				
Pe.				
G.				
T.D.	3608			

COMPLETE

Date Comm. 5-7-56 JUN 20 1956

8" @ 228/200 WOC MAY 15 '56 3320

MAY 23 '56 29 3539 V10 3549 SP SH

3560 DST 3551-66 up 1 hr 9:00

S. 37" ga. 170 MCF in 10" ga. 134

MCF in 20" ga. 109' MCF in 25" ga.

48' GCM BHP 1230/20" FP 60-80

BHP 1230/20" Arb 3607 RTD

3610 5 1/2 @ 3608/70 MAY 29 '56 CO DD

3632 12 1/2 @ 5 Boph no/w

8 hr Decreased to 1 BFPH JUN 6 '56

DD 3666 TD No Fucina

PB 3621 SF 4/3 8 L

8 12 BFPH 50% wh JUN 13 '56 ✓ JUN 20 '56

P. 15 BOPd + 20 BWpd.