
FORM 51

Stafford KANSAS

Section 20 Township 22 Range 11 W

Well No. # 1 McNickle

Company Barnett Oil

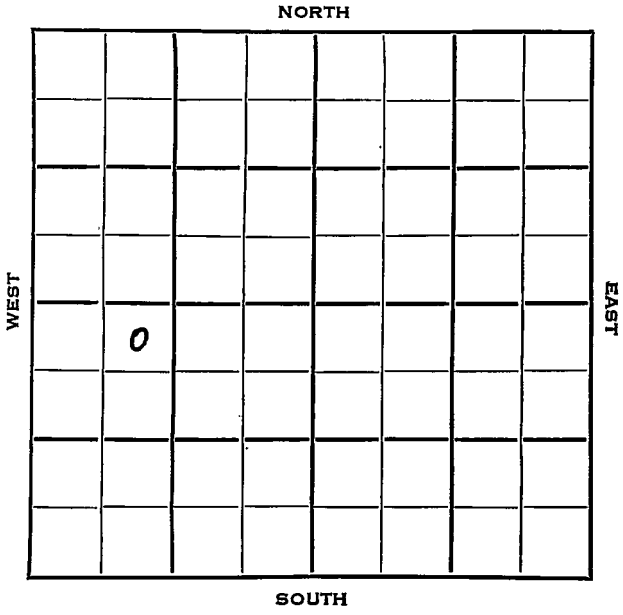

Stafford KANSAS

SEC.	TWP.	R.
20	22	11W

WELL NO.

1 McNickle FARM

COMPANY

Barnett Oil

CONTRACTOR

Barnett Drlg.


Richardson Pool

330 Ft. from N. Line

Ft. from S. Line

Ft. from E. Line

990 Ft. from W. Line

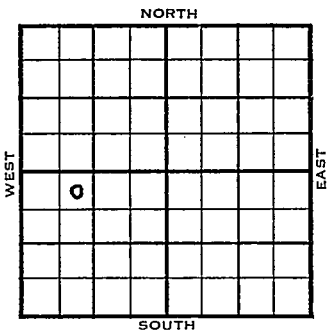

NE NW SW
Stanolind Farmout

1953	ELEVATION 1838' REPORT
9/9	Spud 8-31-53 8" @ 255' Anhy 890' Drlg. 2800'
9/16	Lans 3255, Arb 3551 DST 3595-3605, 20", 1320' oil, 180' V Hly O&GCM, 850# RTD 3607 5" @ 3607'
11/4	Spud 8-31-53 Oil Well TD 3607' 8" @ 255' Anhy 890', Lans 3255, Arb 3551 DST 3595'-3605' opn 20 min, rec 1320' oil, 180' vho & gcm, 850# TD 3607' 5" @ 3607' CO to 3607 2½ boph 12/ 3601-05 FU 300' oil 1 hr 24/ 3593'-3601, FU 1300' oil 1½ hr. 23/ 3585-93 FU 1800' oil 4 hr. 24/ 3577-85 FU 2200' oil 5 hr. 20/ 3570-77 FU 2300' oil 2 hr.

DX-78

OVER

1953

Information brought forward.

11/4 S/ 30 boph 3 hr. SP 3568 22/ 3565-67
wtr & oil 2 hr. wtr. dec. 24/ 3560-68
FU 1100' oil 4 hr. S/ 10 boph 3 hr.
CO to 3605 Heeb 3086', Brlime 3244'
Cong 3517' Simp 3541'
Comp 500 bopd.

COMPLETED

FORM 275 FOR SALE BY KANSAS BLUE PRINT CO.


County Stafford State Kansas

Sec. 20 (Blk. Twp.) 22 (Sur. Rge.) 11W Map No.

Operator Barnett Oil

Well No. 1 Farm McNickle

Elev. 1838 Location NE NW SW

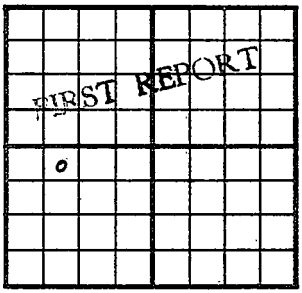

330 Ft. From N Line SW

990 Ft. From W Line Quarter

1st. Report SEP 9 1953

Completion

Remarks Stanolind farmout
Barnett Drlg. - Contr.

Spudding Date 8-31-53

Drlg. Data Richardson Pool

8" @ 255 Anhy 890 drlg. 2800

J. G. McGEHEE

FORM 275 FOR SALE BY KANSAS BLUE PRINT CO.


County Stafford State Kansas

Sec. 20 (Blk. Twp.) 22 (Sur. Rge.) 11W Map No.

Operator Barnett Oil

Well No. 1 Farm McNickle

Elev. 1838 Location NE NW SW

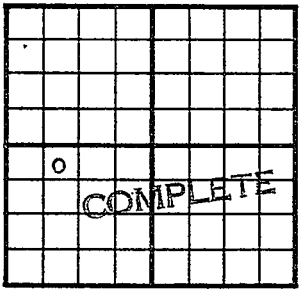

330 Ft. From N Line SW

990 Ft. From W Line Quarter

1st. Report

Completion NOV 4 1953

Remarks Richardson Pool

Barnett Drlg. - Contr.

Spudding Date 8-31-53

Drlg. Data Oil well TD 3607

8" @ 255 Anhy 890 Lans. 3255

Arb. 3551 DST 3595-3605 open 20 min.

Rec. 1320' oil 180' vho & gcm 850#

TD 3607 5" @ 3607 CO to 3607

2½ boph 12/ 3601-05 FU 300' oil 1 hr.

24/ 3593-3601 FU 1300' oil 1½ hr.

23/ 3585-93 FU 1800' oil 4 hr.

24/ 3577-85 FU 2200' oil 5 hr.

20/ 3570-77 FU 2300' oil 2 hr.

S/ 30 boph 3 hr. SP 3568 22/ 3565-67

wtr & oil 2 hr. wtr. dec. 24/ 3560-68

FU 1100' oil 4 hr. S/ 10 boph 3 hr.

CO to 3605 Heeb. 3086 Br. lime 3244

Cong. 3517 Simp. 3541 Comp. 500 bopd

J. G. McGEHEE