

Stafford

KANSAS

SECTION 20 TOWNSHIP 22 RANGE 11 W

WELL NO. #3 McNickle

COMPANY Barnett Oil

NORTH

WEST								EAST

SOUTH

Stafford

KANSAS

SEC.	TWP.	R.
20	22	11W

WELL NO.

#3 McNickle

FARM

COMPANY

Barnett Oil

CONTRACTOR

Barnett

Richardson


Ft. from N. Line

Ft. from S. Line

Ft. from E. Line

Ft. from W. Line

SE NW SW

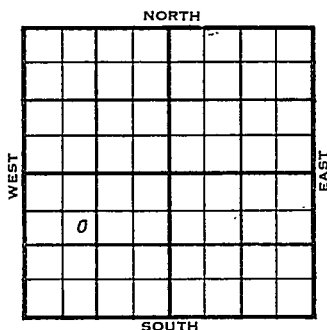

1955

ELEVATION
1836'

REPORT

11-30

RUR

1956

1-11

Comm. 11-28-55
 8 5/8" @ 197/175
 5 1/2" @ 3604/200
 CO to 3598, 23/ 3584-92, 24/ 3576-84
 12/ 3572-76
 FU 950' oil, 150' wtr., 1 hr.
 P/ 5 boph, 7% wtr., 5 hrs.
 Comp. 145 bopd
 H. 3090
 BL. 3227
 KC 3258
 BKC 3476
 C. 3523
 A. 3554
 TD 3605'

COMPLETED

Elev.

Sec. 20

Two

22

Reg.

37W

Company

Barnett Oil

Farm Name

McNickle

No.

3

FIRST REPORT

6

NOV 30 '55

Date Comm.

H U R

50.

Use:

No.

586.

2

अ

County Stafford Elev. 1836
 Sec. 20 Twp. 22 Rge. 11W
 Company Barnett Oil
 Farm Name McNickle No. 3

TOPS	DEPTH	LOG	DATUM	Loc. in Sec.
Anh.				SE NW SW
Tp.				
H.	3090		1254	
Tr.				
Dg.				
Bl.	3227		1391	
L.				
K.C.	3258		1422	Geol.
B.K.C.	3476		1640	Contr.
Ce.				
C.	3523		1687	Barnett
M.				
M.				Pool
K.				Richardson
Mz.				
Mq.				
V.				
S.				
S.				
A	3554		1718	COMPLETE
R.				
PE.				
G.				
T.D.	3605			

Date Comm. 11-28-55 JAN 11 1956
8 5/8" @ 197/175 5 1/2" @ 3604/200
CO to 3598 23/ 3584-92 24/ 3576-84
12/ 3572-76 FU 950' oil 150' wtr. 1 hr.
P/ 5 boph 7% wtr. 5 hr.
Comp. 145 bopd