


Section 20 Township 22 Range 26W

Well No. #1 Clutter

Company John Lindas

NORTH

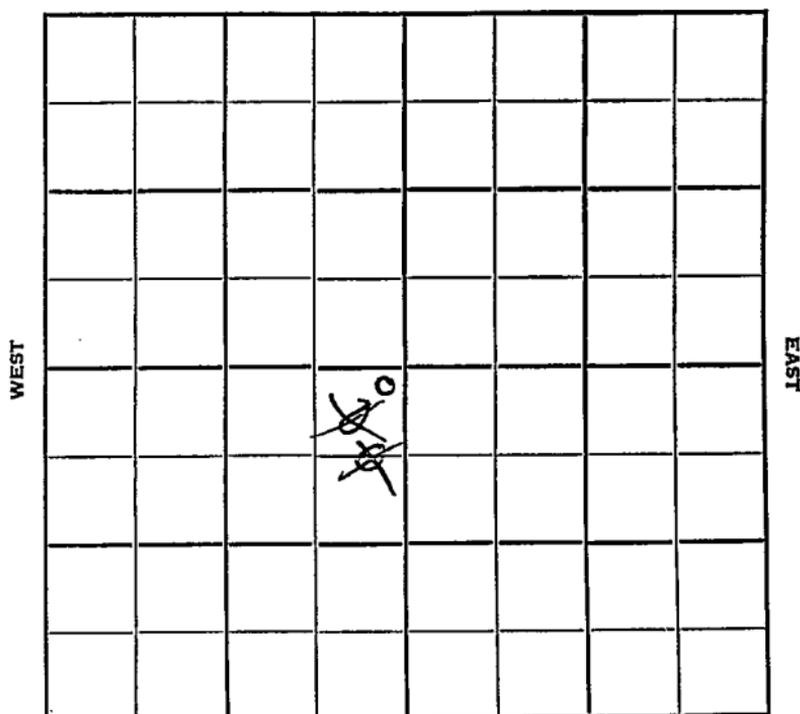

SOUTH

Sec. 20 Twp. 22 R. 26 W

Well No. # 1 Clutter Farm

John Lindas Company


Contractor

~~330~~  
~~330~~ 330 Wildcat  
Ft. from N. Line

\_\_\_\_\_ Ft. from S. Line

330 Ft. from E. Line

\_\_\_\_\_ Ft. from W. Line

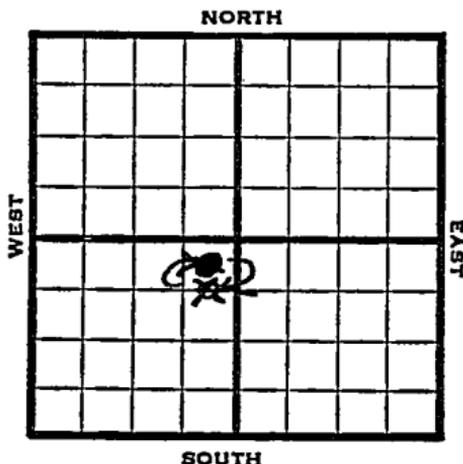

~~NE NE SW~~  
~~CEL NE SW~~  
NE NE SW

1952

Elev. 2502' REPORT

1/2 RUR

1/23 Spud 1-3-52  
D&A TD 4635  
8" @ 256'  
Heeb. 3834' Lans. 3916 Cong. 4520  
Miss. 4543  
TD 4635'  
D&A

**ABANDONED**


County Hodgeman State Kansas

Sec. 20 (Blk. Twp.) 22 (Sur. Rge.) 26W Map No.

Operator John Lindas

Well No. I Farm Clutter

Elev. \_\_\_\_\_ Location NE NE SW

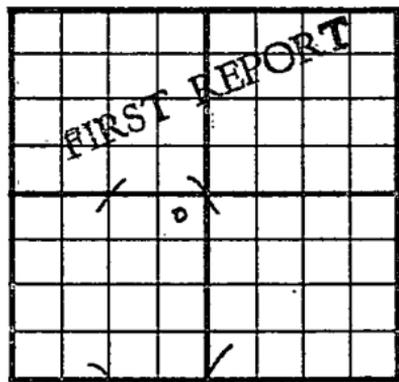

330 Ft. From N Line SW

330 Ft. From E Line Quarter

1st. Report JAN. 2 1952

Completion \_\_\_\_\_

Remarks \_\_\_\_\_

Spudding Date \_\_\_\_\_

Drig. Data Wildcat

R U R

J. E. TYRA

Map No. \_\_\_\_\_ Sec. 20 Twp. 22 R. 26W

Well No. 1 Clutter

John Lindas Company

CONNECTION Contractor

C E L NE SW

SECTION PLAT

660 Ft. from N. Line

\_\_\_\_\_ Ft. from S. Line

330 Ft. from E. Line

\_\_\_\_\_ Ft. from W. Line

	0		

Hodgeman County

Location \_\_\_\_\_

Rig up \_\_\_\_\_

Drilling and Remarks:

Reported

NE NE SW

RECORD

Cased \_\_\_\_\_ in., \_\_\_\_\_ ft.

Sand \_\_\_\_\_

Gas \_\_\_\_\_

Oil \_\_\_\_\_

Total Depth \_\_\_\_\_

PRODUCTION

1st 24 hrs. Nat. \_\_\_\_\_

1st 24 hrs. after shot \_\_\_\_\_

Gas \_\_\_\_\_ Cu. Ft.

Dry Hole \_\_\_\_\_

Abandoned \_\_\_\_\_

Date

JAN 9 1952 19

J. E. TYRA Scout

Map No. \_\_\_\_\_ Sec. 20 Twp. 22 R. 26WWell No. 1 ClutterJohn Lindas Company**CORRECTION** Contractor

NE NE SW

## SECTION PLAT

330 Ft. from N. Line

\_\_\_\_\_ Ft. from S. Line

330 Ft. from E. Line

\_\_\_\_\_ Ft. from W. Line

	o		

Hodgeman County

Location \_\_\_\_\_

Rig up \_\_\_\_\_

Drilling and Remarks:

Re~~corrected~~  
fromC E L NE SW

## RECORD

Cased \_\_\_\_\_ in., \_\_\_\_\_ ft.

Sand \_\_\_\_\_

Gas \_\_\_\_\_

Oil \_\_\_\_\_

Total Depth \_\_\_\_\_

## PRODUCTION

1st 24 hrs. Nat. \_\_\_\_\_

1st 24 hrs. after shot \_\_\_\_\_

Gas \_\_\_\_\_ Cu. Ft.

Dry Hole \_\_\_\_\_

Abandoned \_\_\_\_\_

Date

JAN 16 1952  
19J. E. TYRA

Scout


County Hodgeman State Kansas

Sec. 20 (Blk. 22) (Sur. 26W) Map No.

Operator John Lindas

Well No. 1 Farm Clutter

Elev. 2502 Location NE NE SW

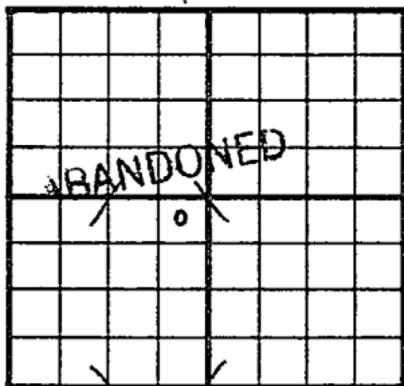

330 Ft. From N Line SW

330 Ft. From E Line Quarter

1st. Report

Completion JAN 23 1952

Remarks Wildcat

Spudding Date 1-3-52

Drlg. Data D & A TD 4635

8" @ 256 Heeb. 3834 Lans. 3916

Cong. 4520 Miss. 4543 TD 4635

D & A

J. G. McGEHEE