


Section 20 Township 22 Range 31 W

Well No. # 1 Ginrich "E"

Company Northern Pump & CRA

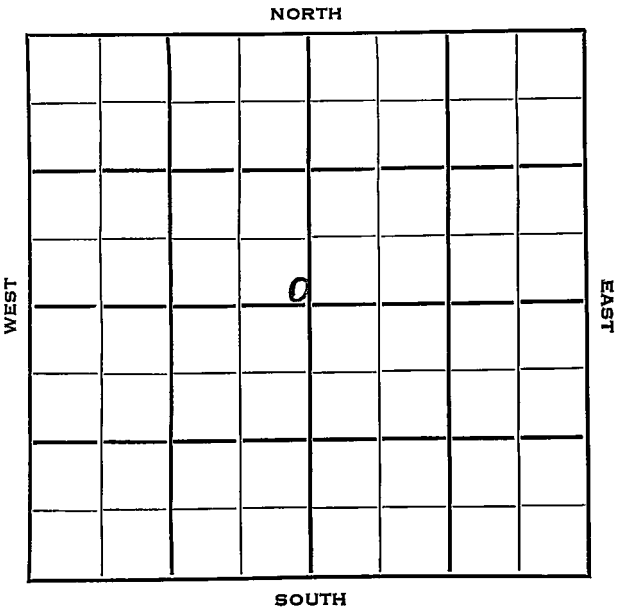

Finney KANSAS

SEC.	TWP.	R.
20	22	31W ✓

WELL NO.

COMPANY 1 Ginrich "E" FARM

CONTRACTOR Northern Pump & CRA

Northern Pump

_____ Ft. from N. Line

100


_____ Ft. from S. Line

100

_____ Ft. from E. Line

_____ Ft. from W. Line

SE SE NW

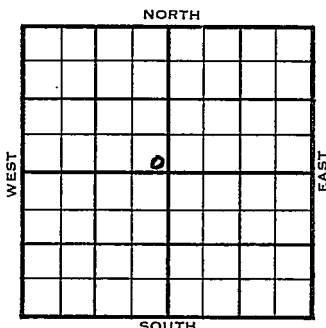

1953	ELEVATION	REPORT
	2902'	

11/18

Spud 11-14-53
8" @ 337'
Drlg. 1905'

1954
3/10

Spud 11-14-53
Gas Well
TD 2755'
8" @ 337'
Her. 2670', Kri 2693', Win 2749'
TD 2755'
5" @ 2753'
CO to 2747'
6/2740-41, 48/2670-78, 108/2694-2712
Dolofrac, 1 bswph
SI 12 hrs. opn 50"
Comp. 2,750,000 gas, 3 bswph

COMPLETED

J. G. McGEHEE

J. G. McGEHEE