


Section 20 Township 22 Range 33W

Well No. 2 Pfeifer

Company Kansas-Nebraska

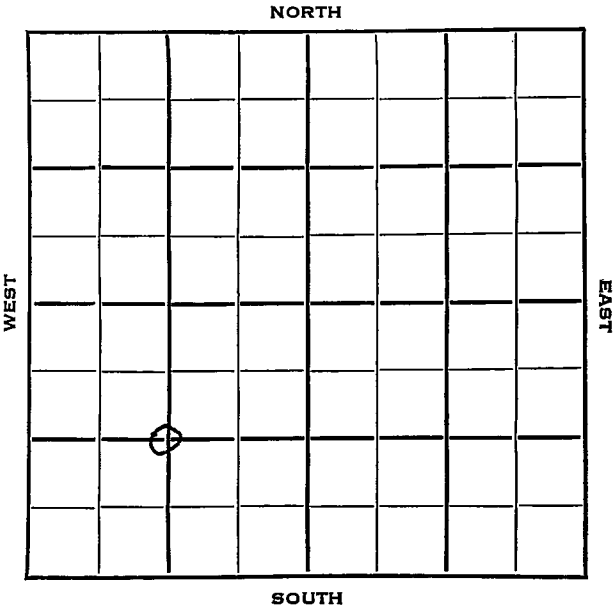

Finney

KANSAS

SEC.	TWP.	R.
20	22	33W ✓

WELL NO.

#2 Pfeifer

FARM

COMPANY

Kansas-Nebraska

CONTRACTOR

Ft. from N. Line

1320


Ft. from S. Line

Ft. from E. Line

1000

Ft. from W. Line

C SW/4

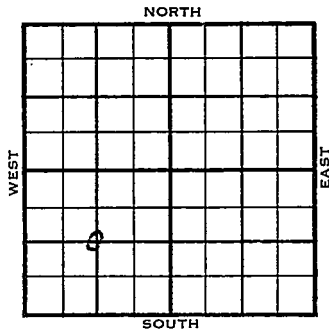

1954

ELEVATION

REPORT

1/27

10" @ 309'

Drlg 1830'

2/3

RTD 2630'

Jeep Log

7" @ 2619'

2/10

C.O. 2606

232/ 2500-2558 104/2578-2604

sd-frac 6000 A

2/17

Her. 2522', Kr. 2542', Win 2576'

2/24

Gas well TD 2630 10" @ 309'

Her. 2522 Kri. 2542 Win. 2576

TD 2630 7" @ 2619 CO to 2606


232/2500-58 104/2578-2604 sd-frac.

6000 A

Comp. 14,400,000 gas.

COMPLETED

County Finney State Kansas
 Sec. 20 (Blk.) 22 (Sur.) 33W Map No.
 Operator Kansas-Nebraska
 Well No. 2 Farm Pfeifer
 Elev. _____ Location C SW/4

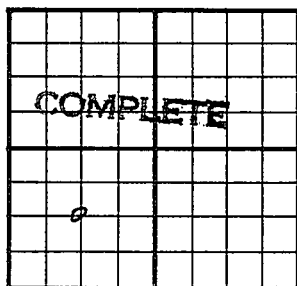

1320 Ft. From S Line SW

1000 Ft. From W Line Quarter

1st. Report

Completion FEB 24 1954

Remarks

Spudding Date

Drilg. Data Gas well TD 2630

10" @ 309 Her. 2522 Kri. 2542

Win. 2576 TD 2630 7" @ 2619

CO to 2606 232/ 2500-58 104/ 2578-2604

sd-frac 6000 A

Comp. 14,400,000 gas

J. G. McGEHEE