


Section 20 Township 22 Range 35WWell No. #2 RooneyCompany Kansas-Nebraska

NORTH

WEST

EAST

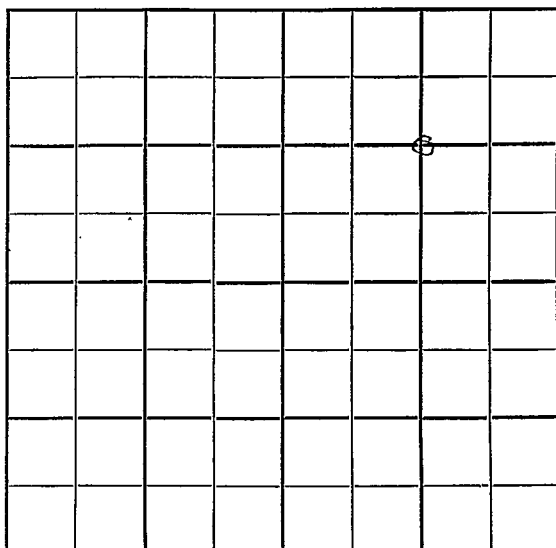

SOUTH

Kearny

KANSAS

Sec. 20 Twp. 22 R. 35 W

Well No. # 2 Rooney Farm

Kansas-Nebraska Company

Hugoton Contractor


1320 Ft. from N. Line

 Ft. from S. Line

1320 Ft. from E. Line

 Ft. from W. Line

C NE

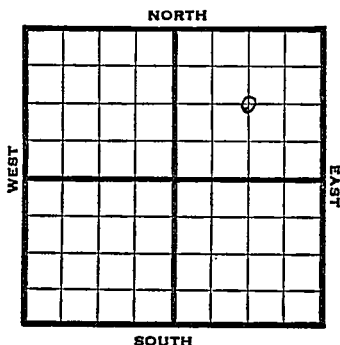

1951

Elev. 3093'

REPORT

10/17

Spud 10-8-51

10" @ 300

Drilling 1675'

12/5

Spud 10-8-51

Gas well TD 2717' 10" @ 300

7" @ 2526' TD 2717'

Her. 2556' Kri 2574' Win. 2614'

Ft. Riley 2679'

TD 2717' 30/2559-69

48/2574-90' 30/2614-24

30/2628-38 81/2690-2717

28,000 A

Comp. 8,300,000 gas.

COMPLETED

County Kearny State Kansas
 Sec. 20 (Blk. Twp.) 22 (Sur. Rge.) 35W Map No.
 Operator Kansas - Nebraska
 Well No. 2 Farm Rooney
 Elev. _____ Location C NE


FIRST REPORT									

1320 Ft. From N Line NE
1320 Ft. From E Line Quarter
 1st. Report OCT 170 1951
 Completion _____
 Remarks _____

 Spudding Date 10-8-51

Drlg. Data Hugoton
10" @ 300 Drlg* 1675

County Kearny State Kansas
 Sec. 20 (Blk. Twp.) 22 (Sur. Rge.) 35W Map No.
 Operator Kansas - Nebraska
 Well No. 2 Farm Rooney
 Elev. 3093 Location C NE/4

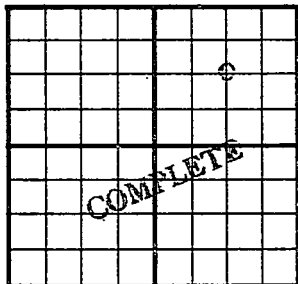

1320 Ft. From N Line NE
1320 Ft. From E Line Quarter
 1st. Report
 Completion DEC 5 1951
 Remarks Hugoton Pool
 Spudding Date 10-8-51

Drlg. Data Gas well TD 2717
10" @ 300 7" @ 2526 TD 2717
Her. 2556 Kri. 2574 Win. 2614
Ft. Riley 2679 TD 2717 30/ 2559-69
48/ 2574-90 30/ 2614-24 30/ 2628-38
81/ 2690-2717 28000 A
Comp. 8,300,000 gas

J. E. TYRA