

O.W.W.O.


FORM 51 25M 3-49 PETROL Stafford

KANSAS

Section 21 Township 22 Range 13W

Well No. #1 Hahn

Company Sunray

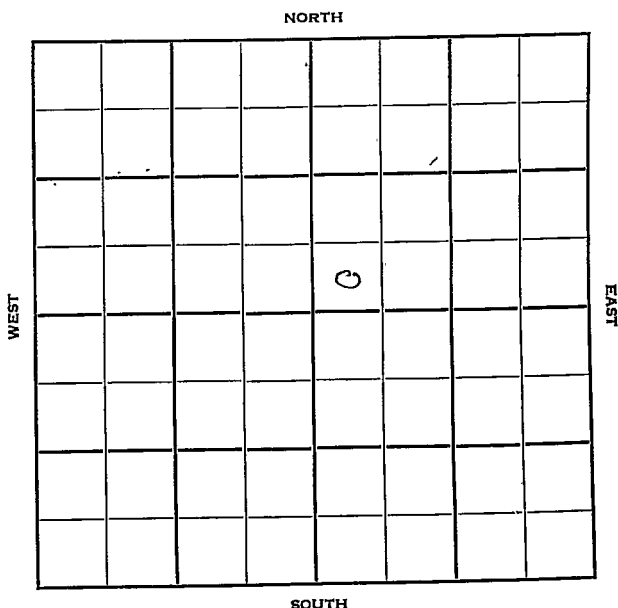

Sec. 21 Twp. 22 R. 13 W

Well No. # 1 Hahn Farm

Sunray Company

Wildcat Contractor

Ft. from N. Line


330 Ft. from S. Line

Ft. from E. Line

330 Ft. from W. Line

SW SW NE

Phillips & Lion - DHM

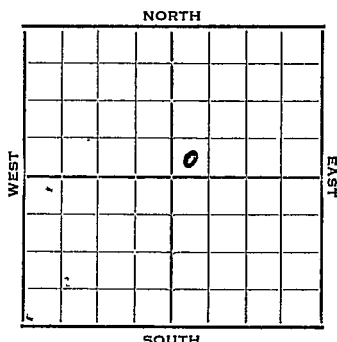

1952 ELEV. 1901' REPORT

11/5 Location

11/12 8" @ 278
Drlg. 2560'

11/20 Heeb 3278' Tor 3298' Douglas 3316'
Br li 3406' Lans. 3450'
DST 3558-82, 1/2 hr, 72' SO & GCM
1225#
DST 3586-98, 1 hr, 17' socm
DST 3600-3618, 1 hr, 180' oil, 60' OCM
60' wtr. 930#
Drlg.

11/27 DST 3692-3720, 1 hr., 20' M
B KC 3659, Marm 3668, Cong 3710,
V 3733, Simp sha 3776, Simp sd
3794
DST 3790-3805, 1 hr., 20' socm,
Arb 3836'
RTD 3839
5" @ 3837

12/4 CO 3839, 250A
S/1-3/4 BOPH 500A
PB 3819, 16/3801-06

12/11 On Pump

12/18 On Pump

12/25 On Pump

OVER

1953

1/1 P/1 $\frac{1}{2}$ BO / 3 BWPH

1/8 NR

1/14

Spud 11-6-52

Oil Well TD 3839

8" @ 278

Heeb 3271, Tor 3298, Doug.

3316, Br lime 3406, Lans 3430

DST 3558-82, opn $\frac{1}{2}$ hr., rec.

72' so & gcm, 1225#

DST 3586-98 opn 1 hr., rec.

17' socm 0#

DST 3600-18, opn 1 hr., rec.

180' oil, 60' ocm, 60' wtr.,

930#

DST 3692-3720, opn 1 hr., rec.

20' mud, 0#

B KC 3659, Marm. 3668, Cong.

3710, Viola 3733, Simp sh

3766, Simp sd 3794

DST 3790-3805, opn 1 hr., rec.

20' 20' socm, 105#

Arb. 3836

TD 3839

5" @ 3837

CO to 3839, 250A

S/1 3/4 boph 500A

PB 3819, 16/3801-06, 1 goph

10/3793-96, 1 3/4 goph

PB 3644

20/3610-15 3/4 boph 8 hrs.

1250A S/90 bo 8 hrs. 3000A

S/84 bo 8 $\frac{1}{2}$ hrs. P/136 bopd

Comp. 16 bopd

COMPLETED

1954

2/17

O.W.W.O.

Oil well TD 3847' KC 3430' Arb 3836

OTD 3839 PB 3644 DD 3847 750 A

12 $\frac{1}{2}$ BOPH 5 hr. P/120 BO 40 BW

48 hr. P/33-35 BOPD 10 BW

Comp.

FIRST REPORT

COMPLETED

J. G. McGENRE

Scout Cards

Land Small Map

Land Water Map

Trailings

Scout's


Map

1952

NOV 7 1952

Orig. Data

County Stafford State Kansas
 Sec. 21 (Blk. 2 2 (Sur. 13W Map No.
 (Twp.) (Rge.)
 Operator Sunray Oil
 Well No. 1 Farm Hahn
 Elev. 1901 Location SW SWNE

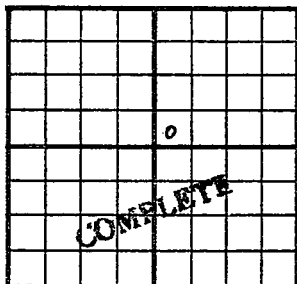

330 Ft. From S Line NE
330 Ft. From W Line Quarter

1st. Report

Completion JAN 14 1953

Remarks Wildcat

Spudding Date 11-6-52

Drig. Data Oil well TD 3839

8" @ 278 Heeb. 3271 Tor. 3298

Doug. 3316 Br. lime 3406 Lans. 3430

DST 3558-82 open 1/2 hr. Rec. 72' so & gcm

1225# DST 3586-98 open 1 hr. Rec. 17'

socm 0# DST 3600-18 open 1 hr.

Rec. 180' oil .60' ocm 60' wtr. 930#

DST 3692-3720 open 1 hr. Rec. 20' mud

0# B KC 3659 Marm. 3668 Cong. 3710

Viola 3733 Simp. sh. 3776 Simp. sd. 3794

DST 3790-3805 open 1 hr. Rec. 20' socm

105# Arb. 3836 TD 3839 5" @ 3837

CO to 3839 250 A S/ 1 3/4 boph 500 A

PB 3819 16/ 3801-06 1 goph 10/ 3793-96

1 3/4 goph PB 3644 20/ 3610-15

J. G. McGEHEE

Scout Cards

Land Small Map

Land Wall Map

Tracings

France Map

Pierce Map

JAN 23 1953

Comp. 16 bopd

3000 A S/ 84 hr 1250A S/ 90 hr 8 hr

3/4 bopd 8 hr 1250A S/ 90 hr 8 hr

Drig. Data

O.W.W.O.

County Stafford State Kansas

Sec. **21** (Blk. **22** (Sur. **13W** Map No.

Operator **Sunray**

Well No. 1 Farm Hahn

Elev. 1904 Location SW SW NE

FIRST POINT

0

COMPLETE

330 Ft. From S Line NE

330 Ft. From W Line Quarter

1st. Report **FEB 17 1954**

Completion FEB 17 1954

Remarks 

Spudding Date _____

Drig. Data Oil well TD 3847

KC 3430 Arb. 3836 OTD 3839 PB 3644

DD 3847 750 A 12 $\frac{1}{2}$ bopb 5 hr.

P/ 120 bo 40 bw 48 hr. P/ 33-35 bopd

10 bw Comp.

J. G. McGEHEE

Scout Cards	<u>MM</u>
Land Small Map	<u>2</u>
Land Wall Map	
Tracings	
France Map	
Pierce Map	
Other	

FEB 19

Orig. Data