

Sec. 21 Twp. 22 R. 13 W

Well No. # 1 Hahn Farm

G-M-R Oil Company

G-M-R Contractor

Wildcat


Ft. from N. Line

330 Ft. from S. Line

Ft. from E. Line

330 Ft. from W. Line

SW SW NW

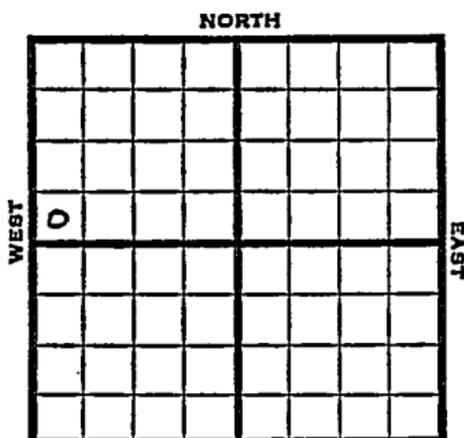

British-American acreage, Stanos, ^{out}ion & Rep.

1951 Elev. 1900' REPORT Nat. DHM

2/7 Spud 2/2/51
8" @ 300'
Anhy 758'
Drlg. 2070'

2/21 Spud 2-2-51
D&A TD 3901
8" @ 300'
Anhy 758' Top. 2988
Heeb. 3302 Br lime 3428
Lans. 3442
DST 3620-31 opn 45 min
Rec. 30' mud Viola 3771'
Simp. 3807' Arb. 3851-3901 TD
D&A

ABANDONED

County Stafford State Kansas

Sec. 21 (Blk. Twp.) 22 (Sur. Rge.) 13W Map No.

Operator G-M-R Oil

Well No. 1 Farm Hahn

Elev. Location SW SW NW

330 Ft. From S Line NW

330 Ft. From W Line Quarter

Ist. Report FEB 7 1951

Completion

Remarks

G-M-R - Contr.

Spudding Date 2-2-51

Drlg. Data Wildcat

British-American acreage, Stano., Lion &

Rep. Nat. DHM

8" @ 300 Anhy 758 drlg. 2070

J. E. TYRA

County Stafford State Kansas

Sec. 21 (Blk. Twp.) 22 (Sur. Rge.) 13W Map No.

Operator G-M-R Oil

Well No. 1 Farm Hahn

Elev. 1900 Location SW SW NW

330 Ft. From S Line NW
330 Ft. From W Line Quarter

Ist. Report

Completion FEB 21 1951

Remarks Wildcat

G-M-R - Contr.

Spudding Date 2-2-51

Drlg. Data D & A TD 3901

8" @ 300 Anhy 758 Top. 2988

Heeb. 3302 Br. lime 3428 Lans. 3442

DST 3620-31 - open 45 min. Rec. 30' mud

Viola 3771 Simp. 3807 Arb. 3851-3901 TD

D & A