


Section 21 Township 22 Range 7 W

Well No. # 1 McVay

Company Texas Company

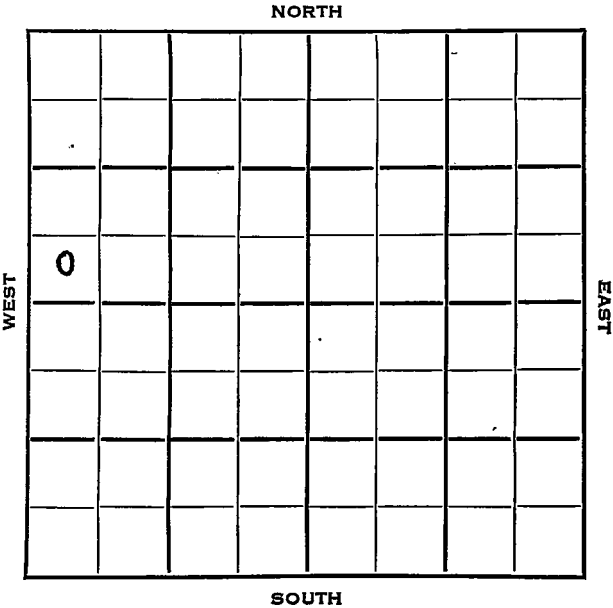

Reno

KANSAS

SEC.	TWP.	R.
21	22	7W ✓

WELL NO.

1 McVay

FARM

COMPANY

Texas Company

CONTRACTOR

Noble Drlg.

Wildcat

Ft. from N. Line

330


Ft. from S. Line

Ft. from E. Line

330

Ft. from W. Line

SW SW NW

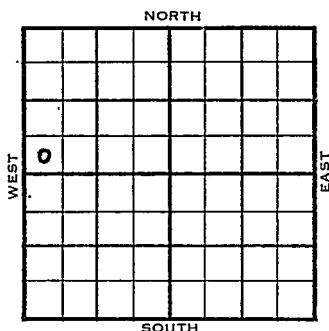

1953	ELEVATION	REPORT
	1594	
10/21	Spud 10-15-53 10" @ 328' Tarkio 2066', Top 2437' Drlg. 2671'	
10/28	Heeb 2747, Doug 2780 DST 2892'-2910' 1 hr, 70' M 1200# Br. L. 2939', Lans 2957' BKC 3338'	
11/4	Spud 10-15-53 D & A TD 3948' 10" @ 328' Tarkio 2066, Top 2437, Heeb 2747, Doug 2780' DST 2892'-2910' opn 1 hr, rec 70' Mud, 1200#, Br. Lime 2939', Lans 2957', B KC 3338', Miss 3459' DST 3460'-70' opn 1 hr rec 215' mud. DST 3465'-80' opn 1 hr, rec 90' vsgcm 200# Kh. 3521, Viola 3792 DST 3793'-3815' opn 1½ hr, rec 430' sw 1395# Simp 3809 Arb 3874 TD 3948' D & A	
	ABANDONED	

County Reino State KansasSec. 21 (Blk.) 22 (Sur.) 7W Map No.Operator Texas CompanyWell No. 1 Farm McVeyElev. Location SW SW NW

0					

FIRST REPORT


330 Ft. From S Line NW330 Ft. From W Line Quarter1st. Report OCT 21 1953

Completion

Remarks

Noble Drlg. - Contr.Spudding Date 10-15-53Drlg. Data Wildcat10" @ 328 Tarkio 2066 Top. 2437drlg. 2671

County Reno State Kansas
 Sec. 21 (Blk. 22 (Sur. 7W Map No.
 (Twp.) (Rge.)
 Operator Texas Company
 Well No. 1 Farm McVay
 Elev. 1594 Location SW SW NW

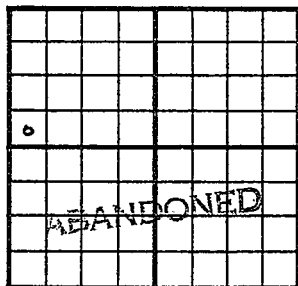

330 Ft. From S Line NW
330 Ft. From W Line Quarter
 1st. Report
 Completion NOV 4 1953
 Remarks Wildcat
Noble Drlg. - Contr.
 Spudding Date 10-15-53

Drlg. Data D & A TD 3948
10" @ 328 Tarkio 2066 Top. 2437
Heeb. 2747 Doug. 2780 DST 2892-2910
open 1 hr. Rec. 70' mud 1200#
Br. lime 2939 Lans. 2957 B KC 3338
Miss. 3459 DST 3460-70 open 1 hr.
Rec. 215' mud DST 3465-80 open 1 hr.
Rec. 90' vsgem 200# Kh. 3521
Viola 3792 DST 3793-3815 open 1½ hr.
Rec. 430' sw 1395# Simp. 3809
Arb. 3874 TD 3948

D & A

J. G. McGEHEE