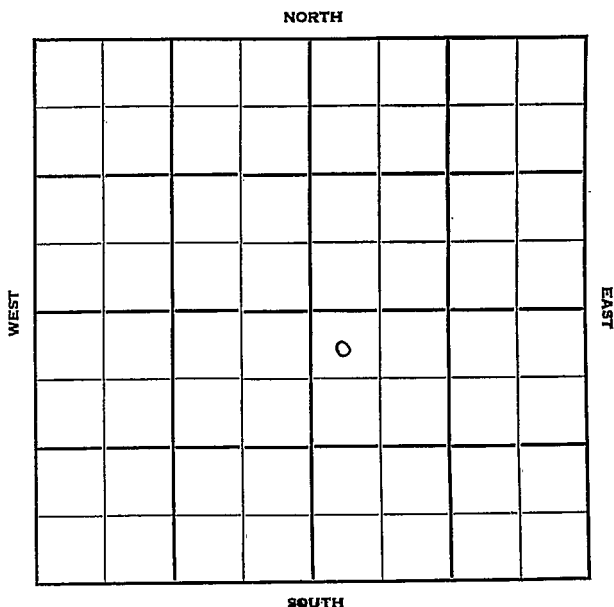


Section 21 Township 22 Range 10W

KANSAS

Well No. #1 SchweizerCompany NCRA & Bradley Bros

Reno

KANSAS

Sec. 21 Twp. 22 R. 10 W

Well No. # 1 Schweizer Farm

NCRA & Bradley Bros. Company

Braden Drlg. Contractor


Wildcat

330 Ft. from N. Line

Ft. from S. Line

Ft. from E. Line

330 Ft. from W. Line

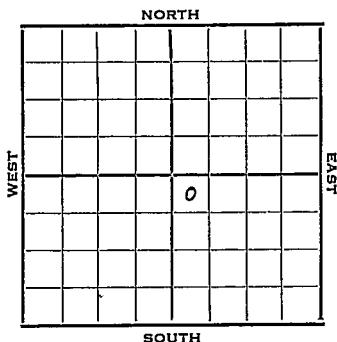

NW NW SE
Phillips DEM

1951 Elev. 1765' REPORT

11/28 Location

1952
1/16

Spud 11-29-51
Oil well TD 3636' 8" @ 245'
Heeb 2998' KC 3173'
DST 3189-3215 open 2 hr. rec 60' mud
DST 3213-35 open 2 hr. rec 90' mud
Cong. 3538' Viola 3541'
DST 3543-50 open 2 hr. rec 30' V
gassy oil & 60' HO & GCM
DST 3545-55 open 2 hr. rec 50' OCM
Simp. 3583'
DST 3580-90 open 2 hr. rec 60' mud &
water, 32' GCM & water Arb. 3631'
TD 3634' 5" @ 3633 DD 3636'
sul. water. PB 3593 32/3548-50
40/3548-56 5 GW 1 hr. 1500 A
S/45 BO 1½ BW 5 hr. FU 2710' oil
100' water, 13 hr. S/25 BO 3 hr.
Comp. 483 BOPD

COMPLETED

County **Reno** State **Kansas**

Sec. 21 (Blk.) 22 (Sur.) 10W Map No.

Operator **N C RA & Bradley Bros.**

Well No. **1** Farm **Schweizer**

Elev.	Location	NW	NW	SE
-------	----------	----	----	----

FIRST REPORT

330' Ft. From N Line SE

330 Ft. From W Line Quarter

1st. Report NOV 28 1951

Completion _____

Remarks Phillips DHM

Braden Drlg. - Contr.


Spudding Date _____

Drig. Data **Wildcat**

Location

J. E. TYRA

County Reno State Kansas
 Sec. 21 (Blk. Twp.) 22 (Sur. Rge.) 10W Map No. _____
 Operator N C R A & Bradley Bros.
 Well No. 1 Farm Schweizer
 Elev. 1765 Location NW NW SE

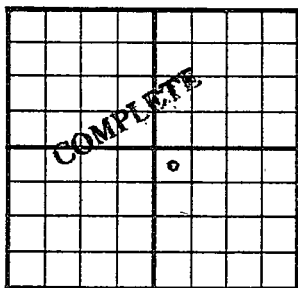

330 Ft. From N Line SE
330 Ft. From W Line Quarter
 1st. Report _____
 Completion JAN 16 1952
 Remarks Wildcat
Braden Drlg. - Contr.
 Spudding Date 11-29-51

Drlg. Data Oil well TD 3636

8" @ 245 Heeb. 2998 KC 3173

DST 3189-3215 open 2 hr. Rec. 60' mud

DST 3213-35 open 2 hr. Rec. 90' mud

Cong. 3538 Viola 3541 DST 3543-50

open 2 hr. Rec. 30' v. gassy oil &

60' ho & gcm DST 3545-55 open 2 hr.

Rec. 50' ocm Simp. 3583 DST 3580-90

open 2 hr. Rec. 60' mud & water 32'

gcm & water Arb. 3631 TD 3634

5" @ 3633 DD. 3636 su. water.

PB 3593 32/ 3548-50 40/ 3548-56

5 gw 1 hr. 1500 A S/ 45 bo 1 1/2 bw 5 hr.

FU 2710' oil 100' water 13 hr.

S/ 25 bo 3 hr. Comp. 483 bopd

J. E. TYRA