


Section 21 Township 22 Range 11 W

Well No. # 1 Sleeper "B"

Company Adair & Fleming

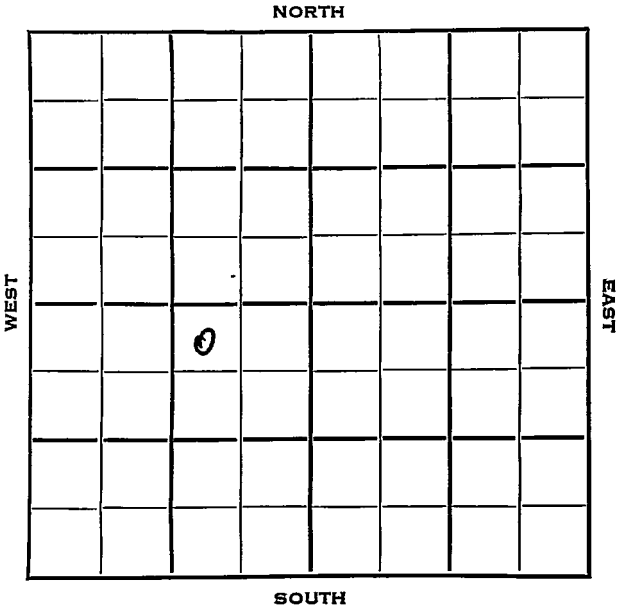


Sec. 21 Twp. 22 R. 11W

Well No. #1 Sleeper "B" Farm
Adair & Fleming Company
Adair & Fleming Contractor

330 Ft. from N. Line
Ft. from S. Line
990 Ft. from E. Line
Ft. from W. Line

NW NE SW

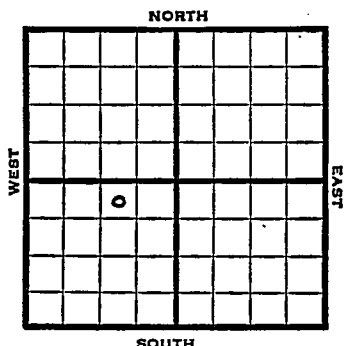


1953 Elev. 1814' REPORT

5/20 MIR
5/28 8" @ 224'
Drlg 3100'
6/3 Heeb 3075, Br li 3212, Lans 3237,
Marm 3486, Cong 3521, V 3529,
Simp 3549, Arb 3600
RTD 3605
5" @ 3603'
6/10 WOCT
6/24 CO 20 boph
7/1 N.R.
7/8 NR
7/15 Spud 5-18-53
Oil Well
TD 3610
8" @ 224'
Heeb 3075, Br lime 3212, Lans 3237,
Marm 3486; Cong 3521; Viola 3529,
Simp 3549, Arb 3600
TD 3605
5" @ 3603, CO to 3610, FU 300' oil,
1/2 hrs., 20 boph
Comp. 176 bopd

COMPLETED

H I R

County Stafford State Kansas
 Sec. 21 (Blk.) 22 (Sur.) 11W Map No.
 Operator Adair & Fleming
 Well No. 1 Farm Sleeper "B"
 Elev. 1814 Location NW NE SW

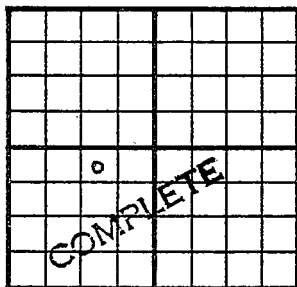

330 Ft. From N Line SW
990 Ft. From E Line Quarter

Ist. Report

Completion JUL 15 1953

Remarks

Adair & Fleming - Contr.

Spudding Date 5-18-53

Drlg. Data Oil well TD 3610

8" @ 224 Heeb. 3075 Br. lime 3212

Lans. 3237 Marm. 3486 Cong. 3521

Viola 3529 Simp. 3549 Arb. 3600

TD 3605 5" @ 3603 CO to 3610

FU 300' oil $\frac{1}{2}$ hr. 20 bopd

Comp. 176 bopd

J. G. McGEHEE