


Section 21 Township 22 Range 11 W

Well No. # 3 Sleeper

Company Adair & Fleming

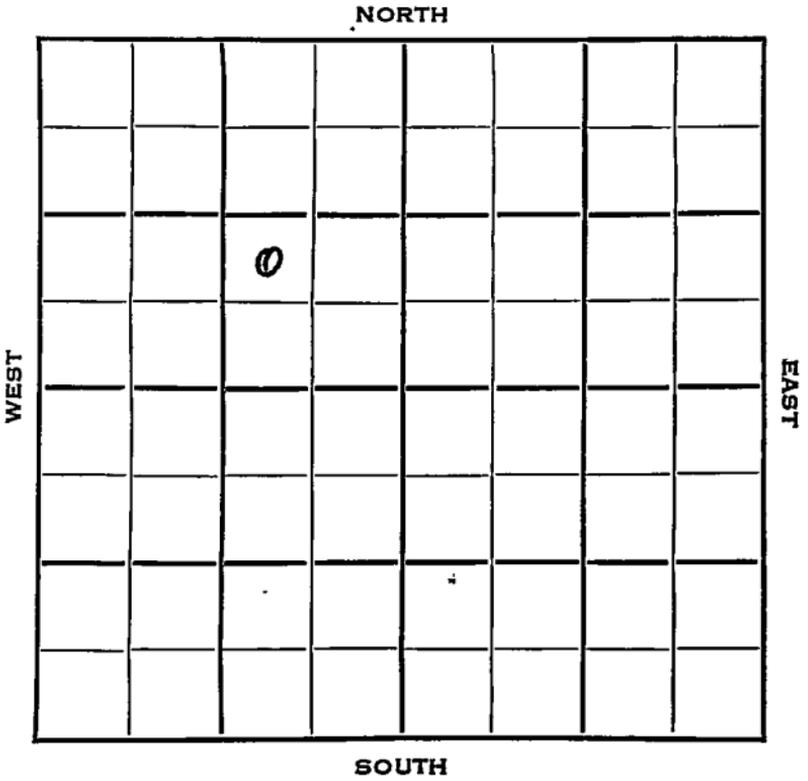

Sec. 21 Twp. 22 R. 11W

Well No. #3 Sleeper Farm

Adair & Fleming Company

Adair Contractor
Sleeper Pool


Ft. from N. Line

990 Ft. from S. Line

990 Ft. from E. Line

Ft. from W. Line

NW SE NW

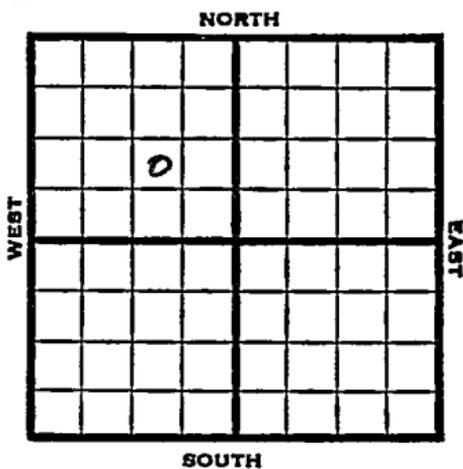

1953

Elev. 1812' REPORT

6/3

RUR

6/10

8" @ 218- Heeb 3081 Br li 3221
Lans 3246
Drlg. 3325

6/17

Spud 6-2-53 D & A TD 3637'
8" @ 218 Heeb 3081 Br lime 3221
Lans 3246 Marm. 3498 Cong 3532
Viola 3540' Simp 3566 Arb 3619'
TD 3637' D & A

ABANDONED

