


Map No. _____ Sec. 21 Twp. 22 R. 11-W

Well No. #1-Leidigh Farm
C. E. Skiles et al Company

NORTH

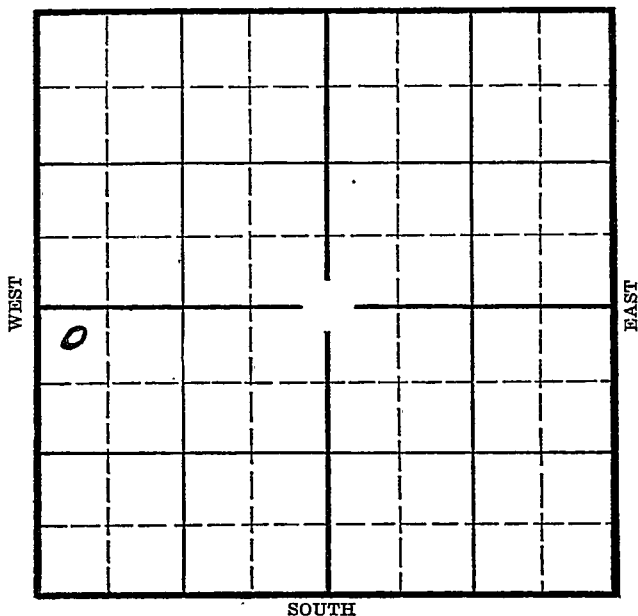

Location_____

Drilling Remarks

Rig Up_____


Drilling Remarks

RECORD

Cased _____ in. _____ ft.
 Sand _____
 Gas _____
 Oil _____
 Total Depth _____

PRODUCTION

1st 24 hrs. Nat. _____
1st 24 hrs. after shot _____
Gas _____ cu. ft. _____
Dry Hole _____
Abandoned _____

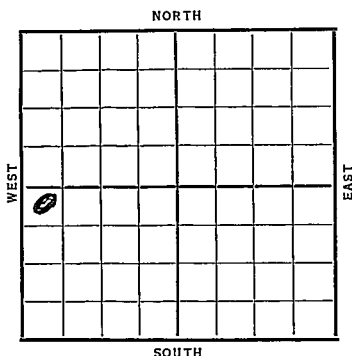Sec. 21 Twp. 22 R. 11-WWell No. #1-Leidigh FarmC. E. Skiles et al Company330 Ft. from N. Line Ft. from S. Line Ft. from E. Line330 Ft. from W. LineDate
1936

REPORT

9/16 Rig

9/24 Anhydrate 563'. 15" @ 567'. Dlg.

10/1 Drlg. 1350'.

10/8 10" @ 1868'. Drlg. 1965'.

10/15 8" @ 2069'. Drlg. 2120'.

10/22 Drlg. 2310'.

10/29 8" @ 2205'. Drlg. 2550'.

11/6 8" @ 2570' 2½ M Gas 2760-67

Drlg. 2815

11/12 8" @ 2985 Drlg.

11/19 Drlg. 3085'.

11/27 Lansing 3260'. 6" @ 3262' Drlg.

12/3 H. F. W. 3375'. Shut down.

12/10 T. D. 3505'. Shut down.

12/17 Simpson 3580'. Sil 3634'.

T. D. 3648'. 200' oil.

12/22 Sil. 3634'. T. D. 3653'.

H. F. W. 3650'.

ABANDONED

KANSAS

Map No. 46 Sec. 21 Twp. 22 R. 11WWell No. 1 LeidlighO E Shiles & Co Company

Contractor

SECTION PLAT

0			

330 Ft. from N. Line

_____ Ft. from S. Line

_____ Ft. from E. Line

330 Ft. from W. Line

FIRST REPORT

Location _____

Rig up _____

Drilling and Remarks:

Rig

RECORD

Cased _____ in., _____ ft.

Sand _____

Gas _____

Oil _____

Total Depth _____

PRODUCTION

1st 24 hrs. Nat. _____

1st 24 hrs. after shot _____

Gas _____ Cu. Ft.

Dry Hole _____

Abandoned _____

Date

SEP 16 1936 19 _____ S. J. LEWIS _____ Scout

KANSAS

Map No. 46 Sec. 21 Twp. 22 R. 11WWell No. 1 LeidighO F Skiles Company

Contractor

SECTION PLAT

0			

330 Ft. from N. Line Ft. from S. Line Ft. from E. Line330 Ft. from W. Line

ABANDONED

Location Rig up

Drilling and Remarks:

Oil 3634HPW 3650J & H

RECORD

Cased in., ft.Sand Gas Oil Total Depth 3653

PRODUCTION

1st 24 hrs. Nat. 1st 24 hrs. after shot Gas Cu. Ft.Dry Hole Abandoned

Date

DEC 22 1936 19

S. J. LEWIS Scout