

# KANSAS


Stafford

FORM 51 5M 1-42 PETROL

Section 21 Township 22 Range 12-W

Well No. #1 Ukens

Company Stanolind

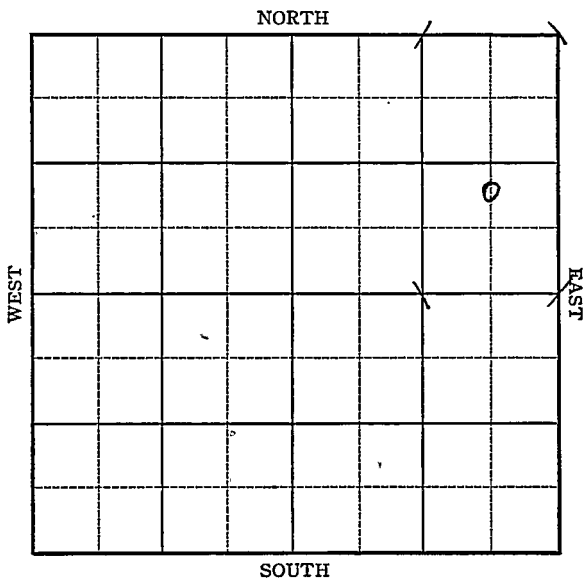

Sec. 21 Twp. 22 R. 12-W

Well No. #1 Ukens Farm

Stanolind Company

Spangenberg


\_\_\_\_\_ Ft. from N. Line

990 Ft. from S. Line

660 Ft. from E. Line

\_\_\_\_\_ Ft. from W. Line

*Elev. 1861*

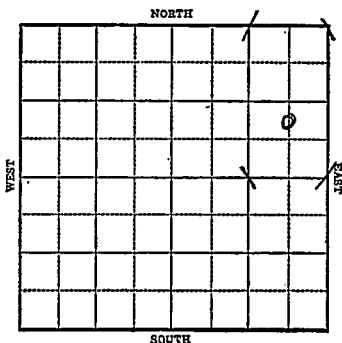

1943

R E P O R T

4/21 Location.

4/28 Surface hole

5/5 10" @ 252'  
Drlg. 2705'

5/12 Lans 3330  
SO 3444-45  
Sat 3445-47  
Drlg. 3451'

5/19 Viola 3588  
Simp 3622  
Arb 3693  
T.D. 3705 Water.

5/26 " " "

6/2 500 acid 20 water per hr  
plug back to Lans.

6/9 Arb. 3695  
7" @ 3695'  
T.D. 3702'  
Water.

**ABANDONED**

KANSAS

Map No. 4 Sec. 21 Twp. 22 R. 12 WWell No. 1 UkensStanolind CompanyFIRST REPORT ContractorC  $N\frac{1}{2}$  SE NE         Ft. from N. Line990 Ft. from S. Line660 Ft. from E. Line         Ft. from W. Line

## SECTION PLAT

			o

## SPANGENBERG POOL

Location XXXRig up         

Drilling and Remarks:

## RECORD

Cased          in.,          ft.Sand         Gas         Oil         Total Depth         

## PRODUCTION

1st 24 hrs. Nat.         1st 24 hrs. after shot         Gas          Cu. Ft.Dry Hole         Abandoned         

Date

APR 21 1943 19 S. J. LEWIS Scout

Stafford

**KANSAS**

Map No. 46 Sec. 21 Twp. 22 R. 12W

Well No. 1 Ukens

Stanolind Company

**ABANDONED** Contractor

C N $\frac{1}{2}$  SE NE

**SECTION PLAT**

\_\_\_\_\_ Ft. from N. Line

990 Ft. from S. Line

660 Ft. from E. Line

\_\_\_\_\_ Ft. from W. Line

			6

**SPA NGENBERG POOL**

Location \_\_\_\_\_

Rig up \_\_\_\_\_

Drilling and Remarks:

*Core 83695  
7" @ 83695  
Water*

**RECORD**

Cased \_\_\_\_\_ in., \_\_\_\_\_ ft.

Sand \_\_\_\_\_

Gas \_\_\_\_\_

Oil \_\_\_\_\_

Total Depth 8212

**PRODUCTION**

1st 24 hrs. Nat. \_\_\_\_\_

1st 24 hrs. after shot \_\_\_\_\_

Gas \_\_\_\_\_ Cu. Ft.

Dry Hole \_\_\_\_\_

Abandoned \_\_\_\_\_

Date

**JUN 9 1943**

19

**S. J. LEWIS** Scout