


DX 78-1

Stafford KANSAS

Section 21 Township 22 Range 12W

Well No. 1 Spangenberg

Company Shawver-Armour & Stanolind

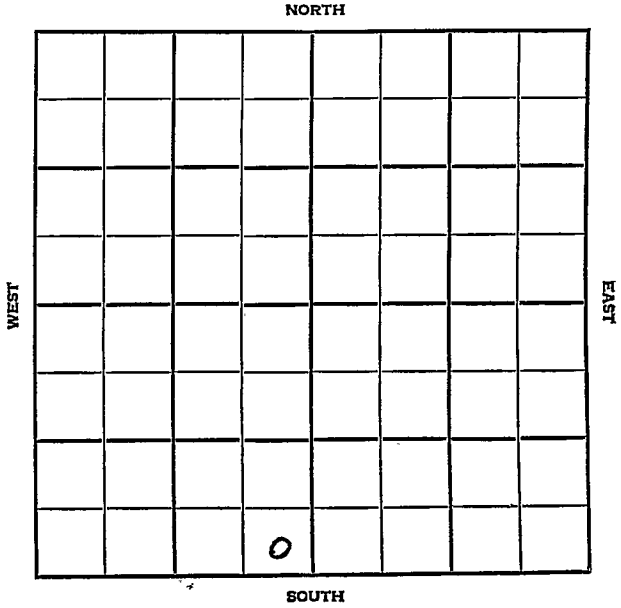

Stafford

KANSAS

SEC.	TWP.	R.
21	22	12 W

WELL NO. # 1 Spangenberg FARM

COMPANY

CONTRACTOR Shawver-Armour & Stanolind


Co. tools Wildcat

_____ Ft. from N. Line

330 _____ Ft. from S. Line

330 _____ Ft. from E. Line

_____ Ft. from W. Line

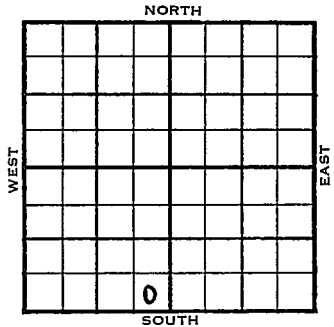

SE SE SW

1955 ELEVATION REPORT

4/20 RUR

