FORM 51

Stafford KANSAS

Section 21 Township 22 Range 12 W

Well No. # 1 Spangenberg

Company Chas. Hulme Drlg.

NORTH

WEST

EAST

0

SOUTH

FORM 252-B

Stafford

KANSAS

Sec. 21 Twp. 22 R. 12W

Well No. #1 Spangenberg. Farm

Chas. Hulme Drlg. Company

Hulme Drlg. Contractor

Spangenberg Pool

990 Ft. from N. Line

Ft. from S. Line

330 Ft. from E. Line

Ft. from W. Line

SE NE SE

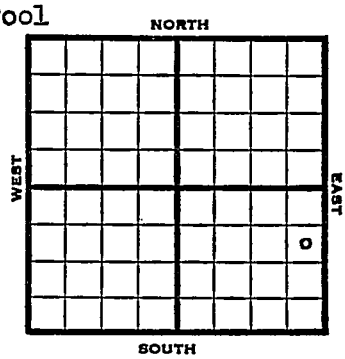

1953	Elev. 1885' REPORT
6/3	Spud 5-23-53 8" @ 545' Anhy 735' Drlg 2885'
6/10	Heeb 3175 Br li 3305 Lans 3328 DST 3452-62, 1/2 hr, 12' M 0# DST 3519-63, 1 hr, 20' OCM, 50' SW 550# V 3593 Simp 3653 Arb 3707 TD 3712 5" @ 3709 WOCT
6/24	WOCT
7/1	Spud 5-23-53 D&A TD 3714 8" @ 545 Anhy 735, Heeb 3175, Br lime 3305, Lans 3328 DST 3452-62, opn ½ hrs., rec. 12' mud, 0# DST 3519-63, opn 1 hr., rec. 20' ocm, 50' sw, 550# Viola 3593, Simp 3653, Arb 3707 TD 3712 5" @ 3709 CO to 3712 FU 800' wtr., DD 3714, wtr inc. D&A

FORM 275 FOR SALE BY KANSAS BLUE PRINT CO.

County Stafford State Kansas

Sec. 21 (Blk. Twp.) 22 (Sur. Rge.) 12W Map No.

Operator Chas. Hulme Drlg.

Well No. 1 Farm Spangenberg

Elev. Location SE NE SE

990 Ft. From N Line SE

330 Ft. From E Line Quarter

1st. Report JUN 3 1953

Completion

Remarks

Hulme Drlg. - Contr.

Spudding Date 5-23-53

FIRST REPORT

Drlg. Data Spangenberg Pool

8" @545 Anhy 735 drlg. 2885

J. G. McGEHEE

FORM 275 FOR SALE BY KANSAS BLUE PRINT CO.

County Stafford State Kansas

Sec. 21 (Blk. Twp.) 22 (Sur. Rge.) 12W Map No.

Operator Chas. Hulme Drlg.

Well No. 1 Farm Spangenberg

Elev. 1885 Location SE NE SE

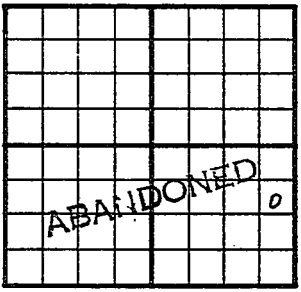

990 Ft. From N Line SE

330 Ft. From E Line Quarter

1st. Report

Completion JUL 1 1953

Remarks Spangenberg Pool

Hulme Drlg. - Contr.

Spudding Date 5-23-53

Drlg. Data D & A TD 3714

8" @ 545 Anhy 735 Heeb. 3175

Br. lime 3305 Lans. 3328 DST 3452-62

open ½ hr. Rec. 12' mud 0# DST 3519-63

open 1 hr. Rec. 20' ocm 50' sw 550#

Viola 3593 Simp. 3653 Arb. 3707

TD 3712 5" @ 3709 CO to 3712

FU 800' wtr. DD 3714 wtr. inc.

D & A

J. G. McGEHEE