

KANSAS


Stafford

FORM 51 5M 1-42 PETROL

Section 21 Township 22 Range 12-W

Well No. #1 Spangenberg

Company Falcon-Seaboard

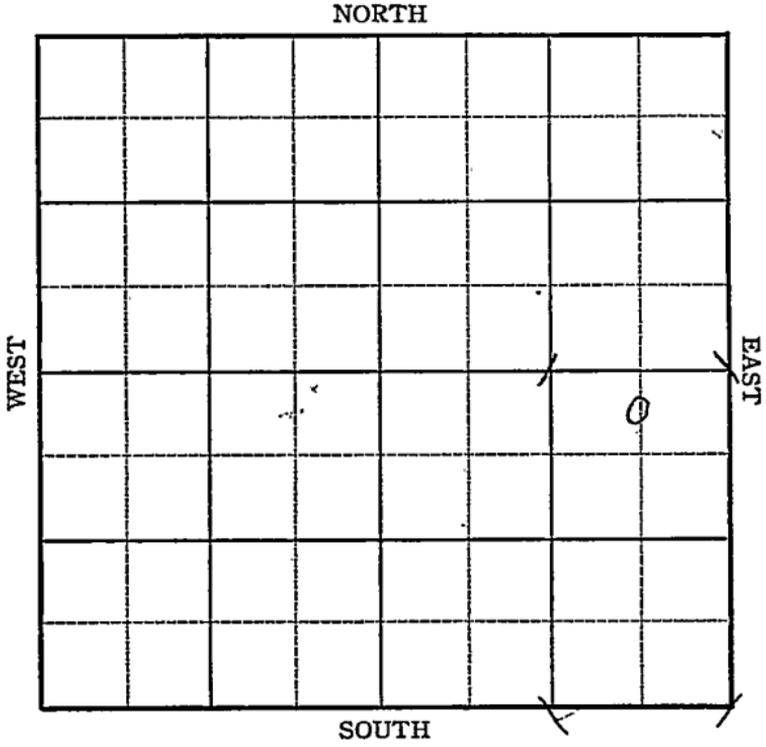

Sec. 21 Twp. 22 R. 12-W

Well No. #1 Spangenberg Farm

Falcon-Seaboard Company

Wildcat


NORTH

330 Ft. from N. Line

_____ Ft. from S. Line

560 Ft. from E. Line

_____ Ft. from W. Line

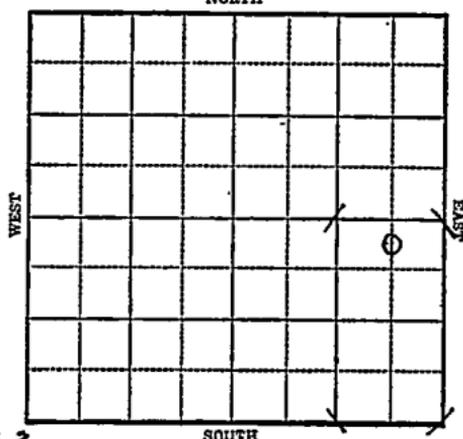

El. 1863

1943

R E P O R T

- 2/10 Location
- 2/17 Derrick
- 2/24 "
- 3/3 8" Casing set 189
Drlg. 1745'
- 3/10 Drlg. 2930'
- 3/17 Bars 3316
Sat Drlg. 3544
- 3/24 Viola 3610
Arb 3691
5" @ 3691-3697 T.D. RUST Sat.
- 3/31 Drlg. 3697 2400' oil 13 hrs.
- 4/7 HFO Swab 7 bbls oil PH 8 hrs.
- 4/14 500 acid pump 97 oil in 6 hrs.
- 4/21 Pum $\frac{1}{2}$ 232 oil 24 hrs $1\frac{1}{2}\%$ water
6% BS
- 4/28 Pump 248 oil & 10% water 24 hrs.
- 5/5 Arb. 3691
5" @ 3691'
T.D. 3697'
500 gal. acid
Pump 228 oil plus 10% water Pot.
Gravity 39.7

COMPLETED


Stafford

KANSAS

Map No. 46 Sec. 21 Twp. 22 R. 12WWell No. 1 SpangenbergFalcon-Seaboard CompanyFIRST REPORT Contractor

C NL NE SE

SECTION PLAT

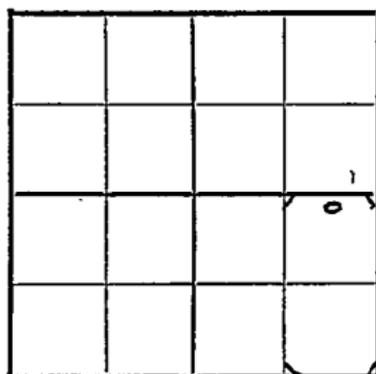330 Ft. from N. Line Ft. from S. Line660 Ft. from E. Line Ft. from W. Line

WILDCAT

Location XXXRig up

Drilling and Remarks:

RECORD

Cased in., ft.Sand Gas Oil Total Depth

PRODUCTION

1st 24 hrs. Nat. 1st 24 hrs. after shot Gas Cu. Ft.Dry Hole Abandoned

Date

FEB 10 1943 19S. J. LEWIS Scout

KANSAS

Map No. 46 Sec. 21 Twp. 22 R. 12W

Well No. 1 Spangenberg

Falcon-Seaboard Company

COMPLETED

Contractor

C NL NE SE

SECTION PLAT

330 Ft. from N. Line

_____ Ft. from S. Line

660 Ft. from E. Line

_____ Ft. from W. Line

			6

WILDCAT

Location _____

Rig up _____

Drilling and Remarks:

Cor 83691
5" @ 3691
500 acid
Run 228 oil +
10% water test.
392 cu

RECORD

Cased _____ in., _____ ft.

Sand _____

Gas _____

Oil _____

Total Depth 2697

PRODUCTION

1st 24 hrs. Nat. _____

1st 24 hrs. after shot _____

Gas _____ Cu. Ft.

Dry Hole _____

Abandoned _____

Date

MAY 5 1943 19

S. J. LEWIS Scout