


Section 21 Township 22 Range 12W

Well No. #2 Spangenberg

Company Hilton Drlg.

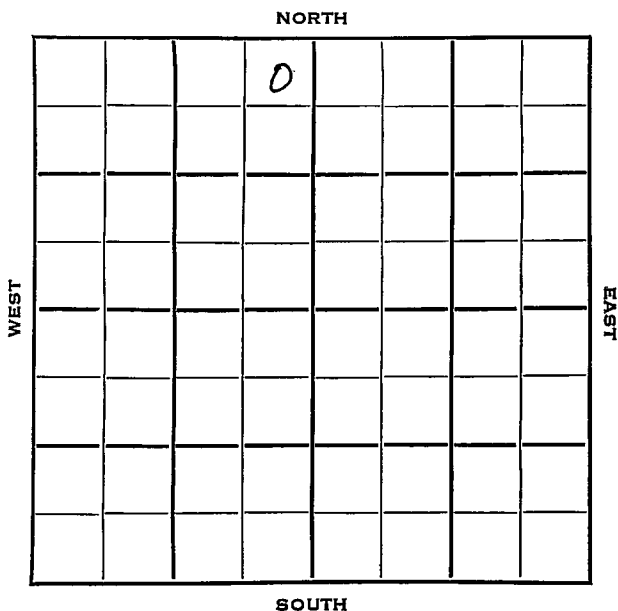

Stafford


KANSAS
12WSec. 21 Twp. 22 R. 12WWell No. #2 Spangenberg FarmHilton Drlg. CompanyHilton Drlg. - Contr. Contractor330 Ft. from N. Line

Ft. from S. Line

330 Ft. from E. Line

Ft. from W. Line

NE NE NW

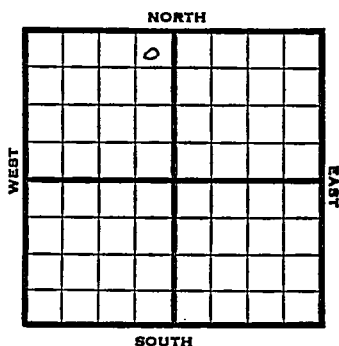

1953 Elev. 1866' REPORT

3/4 Spudded 2/26/53
8" @ 225 Anhy 660
Drlg. 2062

3/12 Heeb 3155, Br li 3286, Lans
3307, V 3564, Simp 3609
Drlg. 3650'

3/19 Arb 3690
RTD 3692
5" @ 3690
CO 3692

3/26 D & A

4/1 Spud 2-26-53
D & A TD 3692½' 8" @ 225
Anhy 660 Heeb 3155 Br lime 3286
Lans 3307' Viola 3564 Simp. 3609
Arb. 3690 TD 3692 5" @ 3690
CO to 3692 DD 3692½ B/1 GWPH 11 hr
21/3689-91 1½ GOPH SP 3670 31/3663
67 ½ GOPH 500 A S/wtr. SP 3610
32/3582-85 2 GW & SSO 500 A wtr.
D & A

ABANDONED

County Stafford State KansasSec. 21 (Blk. Twp.) 22 (Sur. Rge.) 12W Map No.Operator Hilton Drig.Well No. 2 Farm SpangenbergElev. Location NE NE NW

			0				

330 Ft. From N Line NW330 Ft. From E Line Quarter1st. Report MAR 4 1953

Completion

Remarks

Hilton Drig. - Contr.Spudding Date 2-26-53Drig. Data Helene Pool8" @ 225 Anhy 660 drlg. 2062

J. G. McGEHEE

County Stafford State Kansas
 Sec. 21 (Blk. 22) (Sur. 12W) (Twp. Map No.)
 Operator Hilton Drlg.
 Well No. 2 Farm Spangenberg
 Elev. 1866 Location NE NE NW

			0			

ABANDONED

330 Ft. From N Line NW
330 Ft. From E Line Quarter
 1st. Report
 Completion APR 1 1953
 Remarks Helene Pool
Hilton Drlg. - Contr.
 Spudding Date 2-26-53

Drlg. Data D & A TD 3692 $\frac{1}{2}$
8" @ 225 Anhy 660 Heeb. 3155
Br. lime 3286 Lans. 3307 Viola 3564
Simp. 3609 Arb. 3690 TD 3692
5" @ 3690 CO to 3692 DD 3692 $\frac{1}{2}$
B/ 1 gwph 11 hr. 21/ 3689-91
1 $\frac{1}{2}$ goph SP 3670 31/ 3663-67 $\frac{1}{2}$ goph
500 A S/ wtr. SP 3610 32/ 3582-86
2 gw-& SSO 500 A wtr.
D & A

J. G. McGEHEE