

Stafford


FORM 51

KANSAS

Section 21 Township 22 Range 12W

Well No. 1 - J. H. Ukens

Company Stanolind

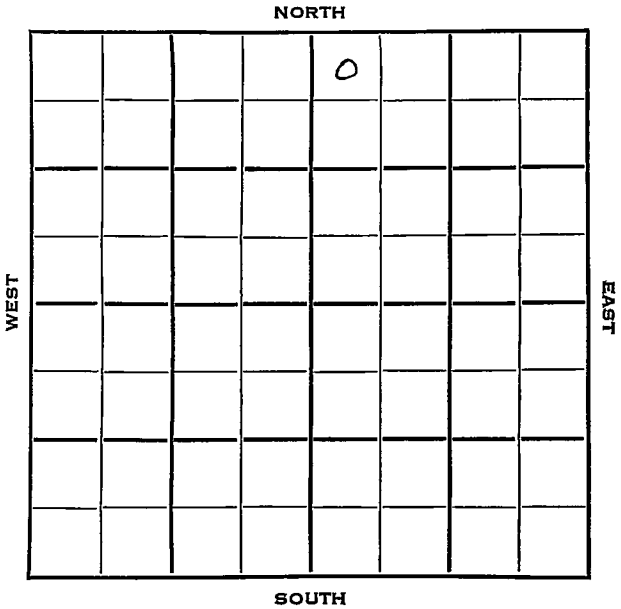

Sec. 21 Twp. 22 R. 12 W

Well No. # 1 J. H. Ukens Farm

Stanolind Company

Contractor


330 Ft. from N. Line

\_\_\_\_\_ Ft. from S. Line

\_\_\_\_\_ Ft. from E. Line

330 Ft. from W. Line

NW NW NE

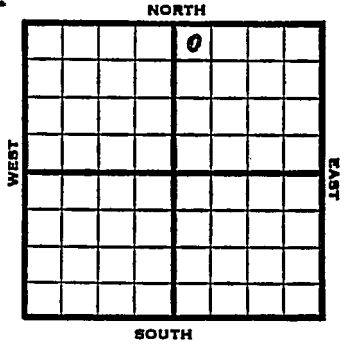

1953

Elev. 1867' REPORT

1/21  
1/29

Location  
"

2/5

8" @ 660  
Drlg. 2970'

2/12

Lans 3305  
DST 3390-3405, 1½ hrs., 90' wtr  
DST 3390-3405, 1 hr., 30' m  
1025#  
DST 3407-3519, 1 hr., 70' wtr  
732#  
Drlg.

2/19

DST 3688-92, 1/2 hrs., 480' oil, 30' sulp wtr 1150#  
RTD 3692  
Arb 3688  
5" @ 3689  
CO 3692  
6 BOPH + 21 BWPH

OVER

#1 J. H. Ukens

1953

2/25

Spud 1-28-53

Oil Well

TD 3692

8" @ 660

Lans 3305

DST 3390-3405, opn  $1\frac{1}{2}$  hrs.,  
rec. 90' wtr.

DST 3390-3405, opn 1 hr., rec.  
30' mud, 1025#

DST 3407-3519, opn 1 hr., rec.  
70' wtr. 732#

DST 3688-92, opn  $\frac{1}{2}$  hrs., rec.  
480' oil, 30' sul wtr 1150#

TD 3692

Arb 3688

5" @ 3689

CO to 3692 6 boph 20 bw

Comp. 87 bopd 27% wtr.

**COMPLETED**

County Stafford State Kansas

Sec. 21 (Blk. Twp.) 22 (Sur. Rge.) 12W Map No.

Operator Stanolind

Well No. 1 Farm J. H. Hkens

Elev. Location NW NW NE

			0		
FIRST REPORT					

330 Ft. From N Line NE

330 Ft. From W Line Quarter

Ist. Report JAN 21 1953

Completion

Remarks

Spudding Date

Drlg. Data

Location

