


Reno

Map No. *Kansas* Sec. *21* Twp. *22* R. *5^W*

Well No. *1 Rowland* Farm
Phillips Pet Company

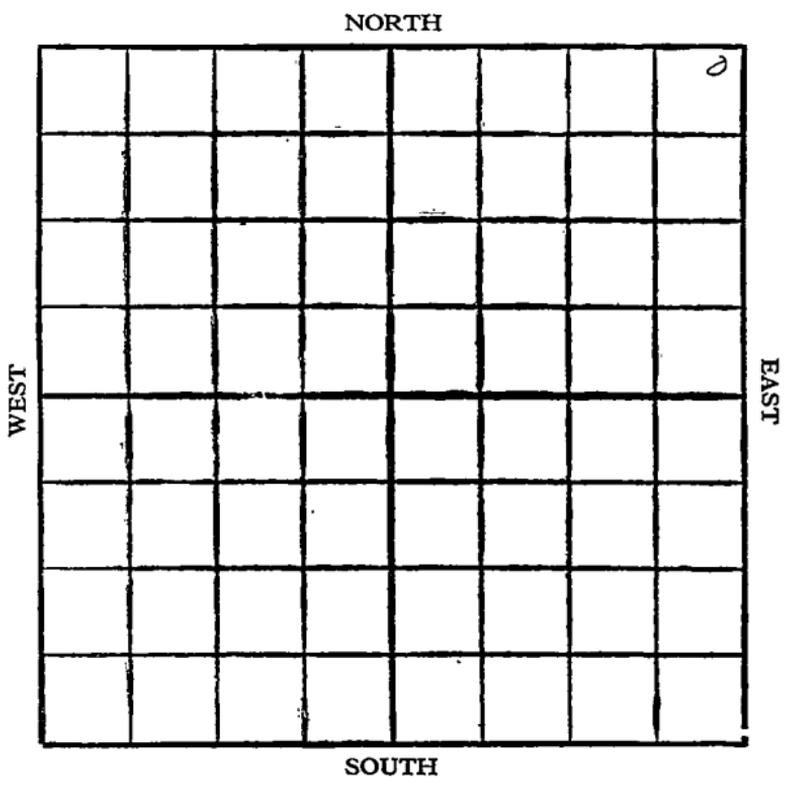

Location

Drilling Remarks

.....

.....

RECORD

Cased..... in. ft.

Sand

Gas

Oil

Total Depth.....

Rig Up.....

Drilling Remarks

.....

.....

PRODUCTION

1st 24 hrs. Nat.....

1st 24 hrs. after shot.....

Gas..... cu. ft.

Dry Hole.....


Abandoned.....

Map No. _____ Sec. 21 Twp. 22 R 5 W

Well No. 1- Rowland Farm

Phillips Pet Company

NORTH

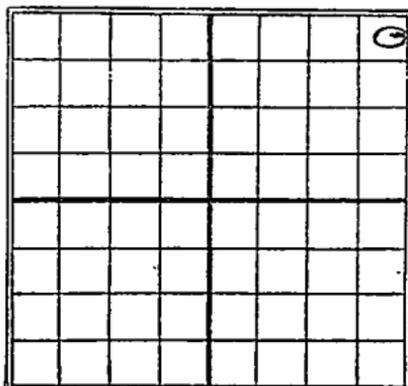

300 Ft. from N. Line

_____ Ft. from S. Line

300 Ft. from E. Line

_____ Ft. from W. Line

1927

Date	REPORT
------	--------

5/11	Location
5/25	R.o.g.
6/1	Reg
6/8	Spud
6/15	Drlg 588
6/22	" 1295
6/29	" 2200
7/6	Run 8" @ 2560
7/13	Drlg 2830
7/20	T.D. 3050 - fishing tools -
7/27	Drlg 3180 -
8/3	" 3300
8/10	T.D. 3483 - u.R. 6" -
8/17	_____
8/23	Drlg 3540
8/31	" 3690
9/7	" 3783
9/21	T.D. 4024 D. & A.

KANSAS

Map No. _____ Sec. 21 Twp. 22 R. 5W

Well No. Rowland

Phillips P. & C. Company

Contractor

SECTION PLAT

			0
	1		

300 Ft. from N. Line

_____ Ft. from S. Line

300 Ft. from E. Line

_____ Ft. from W. Line

FIRST REPORTS

Location ✓

Rig up _____

Drilling and Remarks:

RECORD

Cased _____ in., _____ ft.

Sand _____

Gas _____

Oil _____

Total Depth _____

PRODUCTION

1st 24 hrs. Nat. _____

1st 24 hrs. after shot _____

Gas _____ Cu. Ft.

Dry Hole _____

Abandoned _____

Date

MAY 1 1 1927

S. J. LEWIS

Scout

Leno

MAP NO. *KANONG* SEC. *21* TWP. *57S* R. *5W*

WELL NO. *1 Rowland*

P. P. Co. COMPANY

CONTRACTOR

SECTION PLAT

			<i>0</i>

_____ FT. FROM N. LINE

_____ FT. FROM S. LINE

_____ FT. FROM E. LINE

_____ FT. FROM W. LINE

*OK with
our well*

LOCATION _____

RIG UP _____

DRILLING AND REMARKS:

RECORD

CASED _____ IN. _____ FT.

SAND _____

GAS _____

OIL _____

TOTAL DEPTH *1107K*

PRODUCTION

1ST 24 HRS. NAT. _____

1ST 24 HRS. AFTER SHOT _____

GAS _____ CU. FT.

DRY HOLE

ABANDONED

DATE

9/21 192*7*

SCOUT

Map No. **KANSAS** Sec. 21 Twp. 22 R. 51X

Well No. 1 Rowland

Phillips P. & C. Company

Contractor

SECTION PLAT

300 Ft. from N. Line

_____ Ft. from S. Line

300 Ft. from E. Line

_____ Ft. from W. Line

			0

ABANDONED

Location _____

Rig up _____

Drilling and Remarks:

TII 4024

J. J. A.

RECORD

Cased _____ in., _____ ft.

Sand _____

Gas _____

Oil _____

Total Depth _____

PRODUCTION

1st 24 hrs. Nat. _____

1st 24 hrs. after shot _____

Gas _____ Cu. Ft.

Dry Hole _____

Abandoned _____

Date

SEP 21 1927

S. J. LEWIS

Scout