

Finney


KANSAS

SECTION 21 TOWNSHIP 22 RANGE 32W

WELL NO. #1 Hett "C"

COMPANY Southwestern-Vickers

NORTH

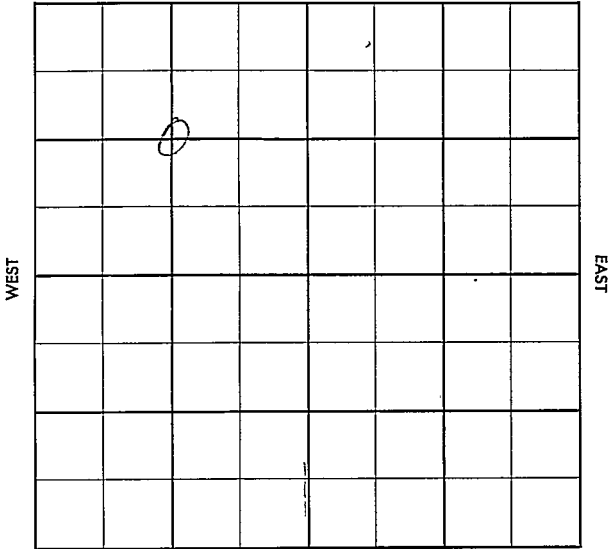

SOUTH

County Finney Elev. _____
 Sec. 27 Twp. 22 Rgs. 32W
 Company Southwestern-Vickers
 FarmName Hett HCD No. 7

TOPS	DEPTH	LOG	DATUM
Anh.			
Tr.			
H.			
Tr.			
Dg.			
Bl.			
L.			
K.C.			
B.K.C.			
Ce.			
C.			
M.			
M.			
K. <u>Win.</u>	<u>2689</u>		
Mz.			
Mo.			
V.			
S.			
S.			
A.			
R.			
PE.			
G.			
T.D.	<u>2725</u>		

Loc. in Sec. _____

C NW/4

Geol. _____

Contr. _____

Rocket

Pool _____

Hugoton

JAN 16 57

FIRST REPORT

Date Comm. 1-10-578" @ 436/375 5" @ 2724/400

25

Co.

Lse.

No.

Sec.

T.

R.

County Finney Elev. 2892
 Sec. 21 Twp. 22 Rge. 32N
 Company Southwestern-Pickers
 Farm Name Hatch "G" No. 1

TOPS	# DEPTH	LOG	DATUM	Loc. in Sec.
Anh: <u>Hell</u>		<u>2595</u>		<u>C NW/4</u>
Tr. <u>Hell</u>		<u>2635</u>		
H. <u>KPI</u>		<u>2647</u>		
Tr. <u>AFH</u>		<u>2686</u>		
Dg.				
Bl.				
L.				
K.C.				Geol.
B.K.C.				Contr.
Ce.				<u>Rocket</u>
C.				
M.				
M.				Pool
K. <u>W.A.</u>	<u>2689</u>			<u>Huron</u>
Mz.				
Mo.				
V.				
S.				
S.				
A.				
R.				
PE.				
G.				
TR.	<u>2725</u>			

FEB 27 '57
 COMPLETE

Date Comm. 1-10-57

8" C 436/375 5" C 2725/400 JAN 23

5" MICT CO R. GRNL

DD 2729 24, 2703-2707 N.S.

78/2690-2703 S.I. 12 hrs 56 G25

Vat FR20 3x3 CO 72, 2652-64

FEB 13 '57 NO G25 120/2628-48 55w

FR20 90 1,490 MLCF S.I. P425

90 3,190 MLCF 120" S.I. 60 hrs

SIP 385 90 1,590 MLCF FEB 20 '57 S.I.

12 hrs 9a 2 1/2 Mill CFL "12757"

SIP 380# 9a 3.570 MLE

Thru + 69.