


Section 21 Township 22 Range 33WWell No. #2 DammeCompany W. L. Hartman

NORTH

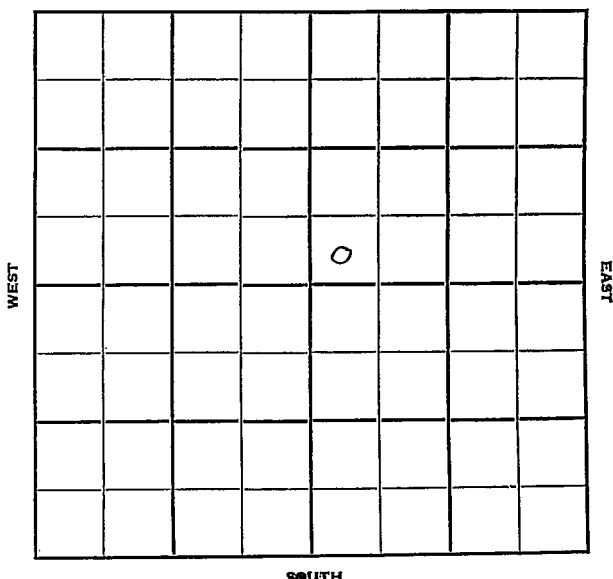

Finney

KANSAS

Sec. 21 Twp. 22 R. 33W

Well No. #2 Damme Farm

W. L. Hartman Company

Contractor

Damme Pool


Ft. from N. Line

330 Ft. from S. Line

Ft. from E. Line

330 _____ Ft. from W. Line

SW SW NE

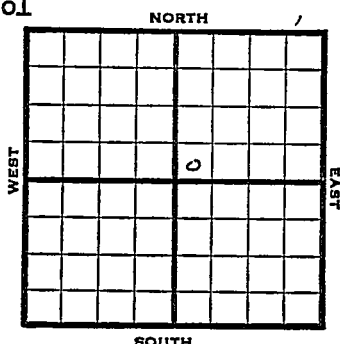

1951

Elev. 2891' REPORT

12/5 Spud 11-21-51

13" @ 295'

Drlg. 2710'

1952

2/6	8 th @ 2710	Acidizing
-----	------------------------	-----------

2/13	4000 A	425,000 gas	PB 25571
------	--------	-------------	----------

72/2540-52 5000 A

2,055,000 gas Set plug 2537'

72/2523-35' 2000 A

2/20 Drove plug to btm. total of 9000 A

3/5 NR

3/12 Spud 11-21-51

Gas well TD 2710' 13" @ 295

Ho1 2489' Her. 2523' Kri 2541'

Ode11 2556' Win. 2572' Ft. Riley

2634' 8" @ 2710' CO to 2702'

90/2634-49 1000 A SS gas

10/25902600 1000 A 4000 A

455,000 gas. PB 2557' 72/2540-52

5000 A 1,488,000 gas 2000 A

2,055,000 gas SP 2537' 72/2523-35

2000 A

Comp. 1,000,000 gas

COMPLETED

County **Finney** State **Kansas**

Sec. 21 (Blk. Twp.) 22 (Sur. Rge.) 33W Map No.

Operator W. L. Hartman

Well No. 2 Farm Damme

Elev.	Location	SW	SE	NE

330' Ft. From S Line NE

330 Ft. From N Line Quarter

1st. Report DEC 5 1951

Completion

Remarks

Spudding Date **11-21-51**

Drig. Data Damme Pool

13" @ 295 drlg. 2710


J. E. TYRA

County Finney State
 Sec. 21 (Blk.) 22 (Sur.) 33W Map No.
 Twp. Rge.

Operator W. L. Hartman

Well No. 2 Farm Damme

Elev. 2891 Location SW SW NE

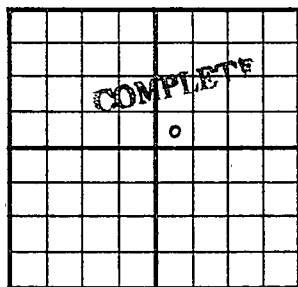

330 Ft. From S Line NE

330 Ft. From W Line Quarter

1st. Report

Completion MAR 12 1952

Remarks Damme Pool

Spudding Date 11-21-51

Drlg. Data Gas well TD 2710

13" @ 295 Hol. 2489 Her. 2523

Kri. 2541 Odell 2556 Win. 2572

Ft. Riley 2634 8" @ 2710 CO to 2702

90/ 2634-49 1000 A SS gas 10/ 2590-

2600 1000 A 4000 A 455,000 gas

PB 2557 72/ 2540-52 5000 A 1,488,000

gas 2000 A 2,055,000 gas SP 2537

72/ 2523-35 2000 A

Comp. 1,000,000 gas