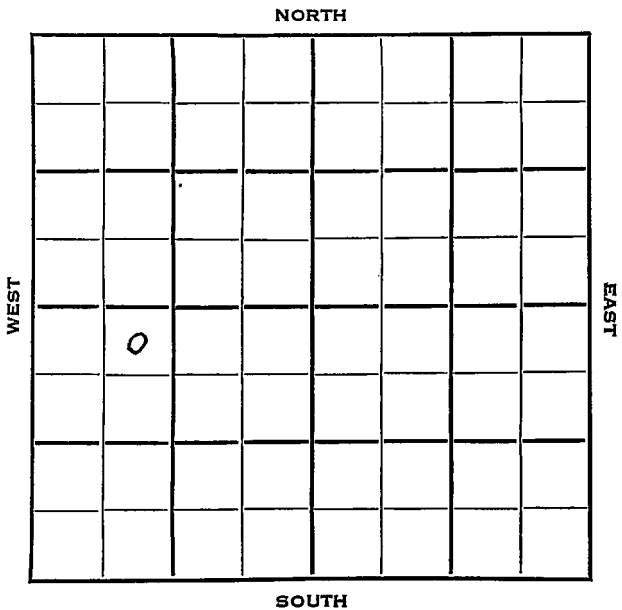


Section 21 Township 22 Range 33WWell No. #3 DammeCompany N.C. R.A.

Finney

KANSAS ✓

Sec. 21 Twp. 22 R. 33WWell No. #3 Damme Farm

N C R A

Company

H & H Drlg.

Contractor

Damme Pool

330

Ft. from N. Line


Ft. from S. Line

Ft. from E. Line

990

Ft. from W. Line

NE NW SW

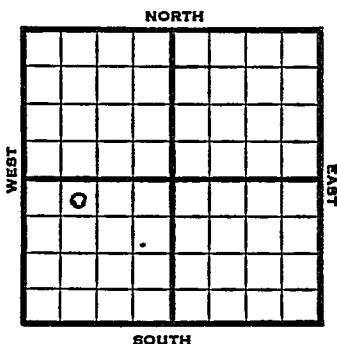

1953

Elev. 2902' REPORT

4/22

Spud 4-114-53
8" @ 260
Drlg. 925'

4/30

Drlg 3785'

5/7

Heeb 2796
Drlg. 4262'

5/21

NR

5/28

NR

6/3

NR

6/24

Spud 4-114-53 Oil well TD 4805
8" @ 260 Heeb 3796 Lans 3838
DST 4407-31 open 2 hr rec 60' wtr.
1150#
DST 4434-63 open 2 hr rec 1005' SW
1390#
Cherokee 4464
DST 4652-57 open 2 hr rec 20' mud
245#
DST 4681-87 open 2 hr. rec 6' mud 0#
Miss 4705
DST 4693-4713 open 2 hr rec 1650' oil
150' MCO 1065#
DST 4745-55 open 2 hr rec 165' oil
110' HOGM 1280#

OVER

1953
6/24

(Information continued)

DST 4743-60 open 2 hr rec 180' oil
30' WCO 1250# TD 4805 5" @ 4805
CO to 4803 20/4792-96 500 A
S/3 $\frac{1}{2}$ BOPH 8-1/3 BWPH 17 hr.
PB 4788 17/4775-79 FU 750'
fluid 90% wtr. 1 $\frac{1}{2}$ hr. S/30 BFPH
90% wtr. 2 hr. S/18-1/3 BO 5 hr
8/4704-06 S/4 $\frac{1}{2}$ BOPH 14 hr. Hydro
S/61 $\frac{1}{2}$ BF 50% wtr. 4 hr.
20/4690-4700 PB 4698 S/44 $\frac{1}{2}$ BF
35% wtr. 3 hr. CO to 4706
PB 4700 CO to 4712 Oil-frac.
S/3.42 BOPH 12/4702-04
S/4 $\frac{1}{2}$ BOPH oil-frac. P/3 BOPH
Comp. 216 BOPD

COMPLETED

J. G. McGEHEE

Sec.	21	(Blk. Twp.)	22	(Sur. Rge.)	33 ^W	Map No.
------	----	----------------	----	----------------	-----------------	---------

Well No. 3 Farm Damme

Elev.	2902	Location	NE NW SW
-------	------	----------	----------

0

COMPLETE

330 Ft. From N Line SW

990 Ft. From W Line Quarter

1st. Report _____

Completion Mar 24 1953

Remarks Damme Pool

H & H Drlg. - Contr.

Spudding Date 4-14-53

Drilg. Data Oil well TD 4805

8" @ 260 Heeb. 3796 Lans. 3838

DST 4407-31 open 2 hr. Rec. 60' wtr.

1150# DST 4434-63 open 2 hr. Rec.

1005' sw 1390# Cherokee 4464

DST 4652-57 open 2 hr. Rec. 20' mud

245# DST 4681-87 open 2 hr.

Rec. 6¹ mud 0# Miss. 4705 DST 4693-

4713 open 2 hr. Rec. 1650' oil

150' mco 1065# DST 4745-55 open 2 hr

Rec. 165' oil 110' hoom 1280# .

DST 4743-60 open 2 hr. Rec. 180' oil

30' wco 1250# TD 4805 5" @ 4805

CO to 4803 20/ 4792-96 500 A

S/ $3\frac{1}{2}$ boph 8 $1\frac{1}{3}$ bwph 17 hr.

J. G. McGEHEE

Drig. Data

PB 4788 17/ 4775-79 FU 750' fluid 90% w

1½ hr. S/ 30 bfph 90% wtr. . 2 hr.

S/ 18 1/3 bo 5 hr. 8/ 4704-06

S/ 4½ boph 14 hr Hydro. S/ 61½ bf

50% wtr. 4 hr. .20/ 4690-4700

PB 4698 S/ 44½ bf 35% wtr. 3 hr.

CO to 4706 PB 4700 CO to 4712

oil-frac S/ 3.42 boph 12/ 4702-04

S/ 4½ boph oil-frac P/ 3 boph

Comp. 216 boph

Scout Cards	_____
Land Small Map	_____
Land West Map	_____
Tract Map	_____
Range Map	_____
Price Map	_____
Misc.	_____

1956