

O. W. P. B.

Finney

KANSAS


FORM 51 25M 3-49 PETROL

Section 21 Township 22 Range 33W

Well No. #1 Damme

Company N C R A

NORTH

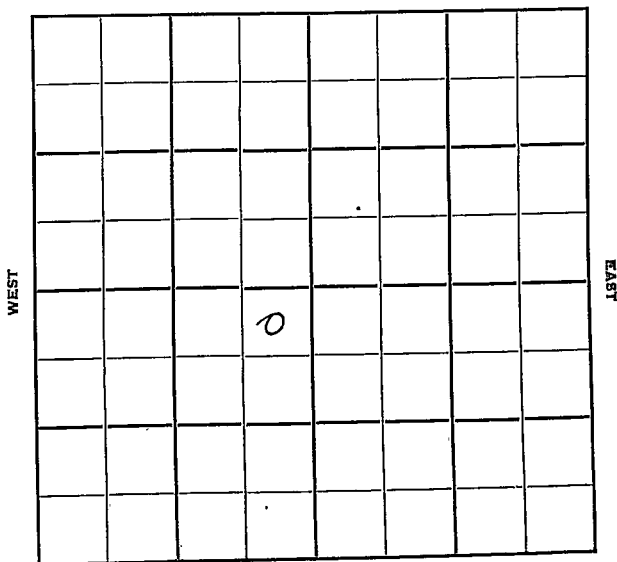

SOUTH

Finney

KANSAS

Sec. 21 Twp. 22 R. 1 33W

Well No. #1 Damme Farm

N C R A Company

Hartman - Contr. Contractor


330' Ft. from N. Line

 Ft. from S. Line

330' Ft. from E. Line

 Ft. from W. Line

NE NE SW

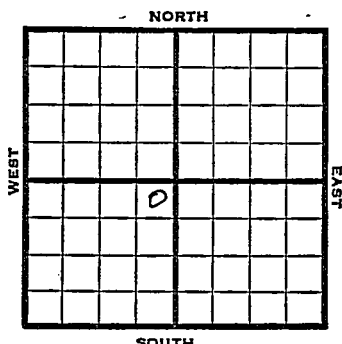

1951

REPORT

~~2905'~~ 2905'

10/24

RUR

12/19

Oil well TD 4727' 8" @ 350'
Heeb 3787' Lans. 3827'
DST 4046-56 open 2 hr. rec 130' sul.
water.
DST 4076-86 open 2 hr. rec 25' water
DST 4396-4422 open 2 hr. rec 160' HOCM
DST 4431-41 open 2 hr. rec 810' oil,
30' mud & oil.
DST 4532-46 open 2 hr. rec 4' mud
Sand 4645' Miss 4653'
TD 4658' 5" @ 4657' DD 4671'
2 GOPH 500 A 2½ BOPH 3000 A
3 BOPH DD 4690' DD 4723'
S/30¼ BO 12 hr. 500 A S/31 BO
9 hr. DD 4727' S/35½ BO 7 hr.
500 A S/50 BO 7 hr. 1500 A
S/92 BO 9 hr.
Comp. 670 BOPD

COMPLETED

County **Finney** State **Kansas**

Sec. 21 (Blk. Twp.) 22 (Sur. Rge.) 33W Map No.

Operator N C R A

Well No. 1 Farm Damme

Elev.	Location	NE	NE	SW

FIRST REPORT

330 Ft. From N Line SW

330 Ft. From E. Line Quarter

1st. Report OCT 24 1951

Completion

Remarks

Hartman - Contr.


Spudding Date _____

Drlg. Data

R U R

J. E. TYRA

County Finney State Kansas
 Sec. 21 (Blk. 22 (Sur. 33W Map No.
 (Twp.) (Rge.)
 Operator N C R A
 Well No. 1 Farm Damme
 Elev. 2905 Location NE NE SW

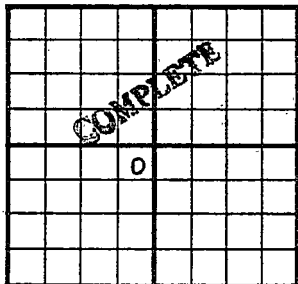

330 Ft. From N Line SW
330 Ft. From E Line Quarter
 1st. Report
 Completion DEC 1 9 1951
 Remarks
Hartman - Contr.
 Spudding Date

Drlg. Data Oil well TD 4727

8" @ 350 Heeb. 3787 Lans. 3827

DST 4046-56 open 2 hr. Rec. 130' sul.

water DST 4076-86 open 2 hr. Rec. 25'

water DST 4396-4422 open 2 hr.

Rec. 160' hoom DST 4431-41 open 2 hr.

Rec. 810' oil 30' mud & oil

DST 4532-46 open 2 hr. Rec. 4' mud

Sand 4645 Miss. 4653 TD 4658

5" @ 4657 DD 4671 2 goph 500 A

2 $\frac{1}{2}$ boph 3000 A 3 boph DD 4690

DD 4723 S/ 30 $\frac{1}{4}$ bo 12 hr. 500 A

S/ 31 bo 9 hr. DD 4727 S/ 35 $\frac{1}{2}$ bo 7 hr.

500 A S/ 50 bo 7 hr. 1500 A

S/ 92 bo 9 hr. Comp. 670 bopd

J. E. TYRA

~~O.W.P.B.~~

S-513-A

CO. Finney ELEV. _____
 SEC. 21 TWP. 22 RGE. 33W
 COMPANY N.C.R.A. NO. 1

FIRST REPORT

NOV 6 1951	

FARM Damme

(O.W.P.B.)

LOC. NE NE SW

~~O.W.P.B.~~

GEOL. _____
 CONTR. _____
 POOL Damme
 SPUD OLD INFO. Log tops:
Marm 4330, Cher 4450, Cher
Sd 4645, Miss 4653, RTD
4658, DD 4727 Complete
12-18-51 for 670.32 BO
n/w (Miss) NEW INFO. -
PB w/sd 4655 Pf 28/4645-52

swb 46 BF (60% wtr) 12 hrs Plug @ 4630 PF
36/4436-45 swb 2.32 BFPH/10 hrs (93% wtr)
500A Swb 88.35 BF (92% wtr) 14 hrs swb 64
BF (94% wtr) 13 hrs Plug @ 4430 PF 20/4417
22 no fluid in 6 hrs 500A, Swb 76 BF (15%
wtr) 10 hrs Grav. 27.9° swb 2.32 BF (14% wtr)
2 hrs POP P 21.4 BO + 7.2 BW 24 hrs P 14.37
BO + 4.72 BW 24 hrs tstg.

LSE. NO. SEC. TWP. RGE.

C. W. P. B.

S-513-A

CO. Finney ELEV. COMPLETE
 SEC. 21 TWP. 22 RGE. 33W
 COMPANY H.C.L.A. NO. 1

NOV 13 57

FARM Dan e

(C.W.P.B.)

LOC NE 1/4 SW

O. W. P. B.

GEOL. _____

CONTR. _____

POOL Danne

SPUD CLD INFO Log to
Marm 4330, Char 4400, 2.32
SD 4445, Miss 4602, 2.32
4658, DD 4727 Complete
12-18-51 for 670.32 20
n/w (Miss) NEL INFO.
PB w/sd 4655 PF 20/4.45

swb 46 EF (50% wtr) 12 hrs Plug 4620 PF
36/4436-45 swb 2.32 LFPH/10 hrs (93.5 wtr)
500A Sub SC.35 LF (92.5 wtr) 14 hrs swb 64
BF (94.5 wtr) 13 hrs Plug - 4430 PF 20/4.17
22 no fluid in 6 hrs 500A. Swb 76 BF (15.5
wtr) 10 hrs Grav. 27.2 swb 2.32 LF (14.5 wtr)
2 hrs FOP P 21. + 7.2 24 hrs I 14.37
BO + 4.72 SW 44 2.35 tstg.

Mar 4417 -22