


Section 21 Township 22 Range 33WWell No. #11 DanneCompany W. L. Hartman

NORTH

WEST

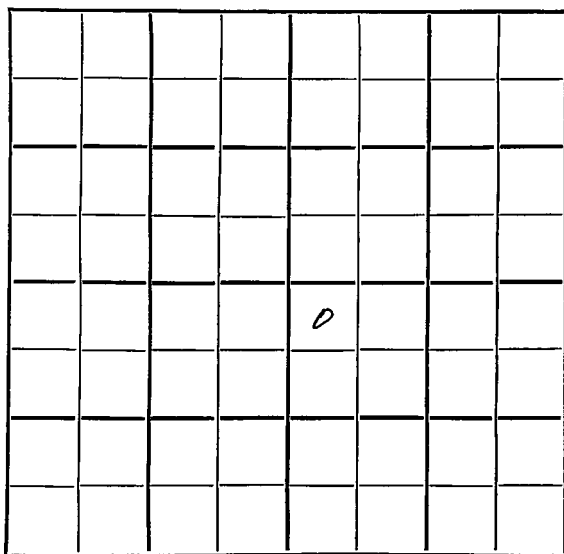

EAST

SOUTH

Finney

KANSAS

Sec. 21 Twp. 22 R. 33W

Well No. #11 Damme Farm

W. L. Hartman Company

Contractor

S. Damme Pool


330 Ft. from N. Line

Ft. from S. Line

Ft. from E. Line

330 Ft. from W. Line

NW NW SE

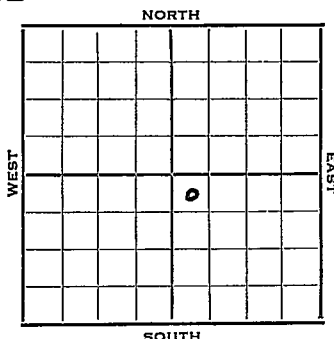

1953 Elev. 2906' REPORT

2/18 Spud 2-14-53
8" @ 306, WOC

2/26 WOC

3/12 Heeb 3795, Lans 3832, Marm
4316
Drlg. 4457'

3/19 Cherokee 4449
Drlg. 4638'

3/26 Patterson sd 4644' Miss 4669'
TD 4684' 5" @ 4684

4/2 NR

4/9 NR

4/16 "

4/23 "

4/30 "

5/7 NR

5/21 NR

5/28 NR

6/3 NR

OVER

1953

6/10

Spud 2-14-53 Oil well TD 4684

8" @ 306 Heeb 3795 Lans 3832

Marm. 4316 Cherokee 4449

Patterson sd 4644 Miss 4669

TD 4684 5" @ 4684 Pay 4668-76

150 A

Comp. 293 BOPD

COMPLETED

County Finney State Kansas

Sec. **21** (Blk. Twp.) **22** (Sur. Rge.) **33W** Map No.

Operator W. L. Hartman

Well No. **11** Farm **Damme**

Elev.	Location	NW	NE	SE	SW
-------	----------	----	----	----	----

FIRST REPORT

330 Ft. From N Line SE

330 Ft. From W Line Quarter

1st. Report FEB 18 1953


Completion

Remarks

Spudding Date . 2-14-53

Drig. Data S. Damme Pool

8th @ 306 WOC

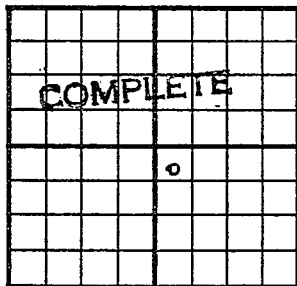County Finney State KansasSec. 21 (Blk.
Twp.) 22 (Sur.
Rge.) 33W Map No.Operator W. L. HartmanWell No. 11 Farm DammeElev. 2906 Location NW NW SE330 Ft. From N Line SE330 Ft. From W Line Quarter1st. ReportCompletion JUN 10 1953Remarks S. Damme PoolSpudding Date 2-14-53Drig. Data Oil well TD 46848" @ 306 Heeb. 3795 Lans. 3832Marm. 4316 Cherokee 4449 Patterson sd.4644 Miss. 4669 TD 4684 5" @ 4684Pay 4668-76 150 A Comp. 293 bopd

J. G. McGEHEE