


Section 21 Township 22 Range 33W  
Well No. #16 Damme  
Company W.L. Hartman

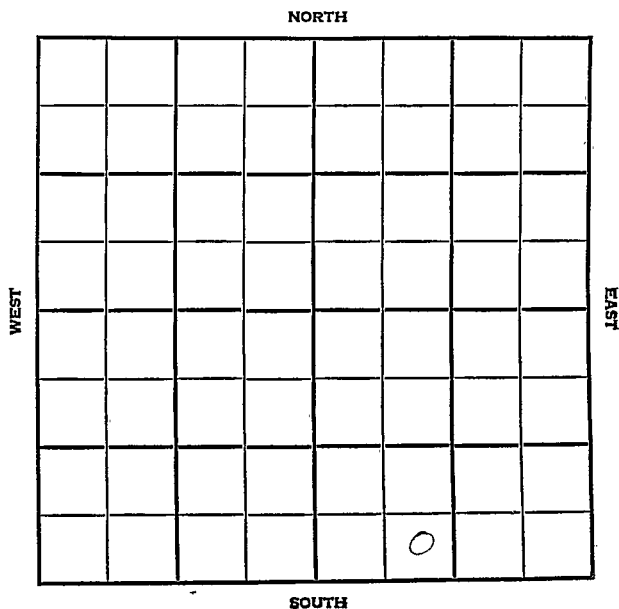

County Finney Elev. 2889  
 Sec. 21- Twp. 22 Rge. 33W  
 Company W. L. Hartman  
 Farm Name Damme No. 16

| TOPS   | DEPTH | LOG | DATUM | Loc. in Sec. |
|--------|-------|-----|-------|--------------|
| Anh.   |       |     |       | SE SW SE     |
| Tp.    |       |     |       |              |
| H.     |       |     |       |              |
| Tr.    |       |     |       |              |
| Dg.    |       |     |       |              |
| BL.    |       |     |       |              |
| L.     |       |     |       |              |
| K.C.   |       |     |       | Geol.        |
| B.K.C. |       |     |       | Contr.       |
| Ce.    |       |     |       | Minter Drlg. |
| C.     |       |     |       |              |
| M.     |       |     |       | Pool         |
| M.     |       |     |       |              |
| K.     |       |     |       |              |
| Mz.    |       |     |       |              |
| Me.    |       |     |       |              |
| V.     |       |     |       |              |
| S.     |       |     |       |              |
| S.     |       |     |       |              |
| A      |       |     |       |              |
| R.     |       |     |       |              |
| Pe.    |       |     |       |              |
| G.     |       |     |       |              |
| T.D.   | 1482  |     |       |              |

FIRST REPORT  
COMPLETED

Date Comm. 8-2-56

FIRST REPORT

8" @ 1325 w/850,

no input figures given, COMPLETE OCT 10 1956

OCT 11 1956