


Section 22 Township 22 Range 7E 11W

Well No. 7 Smith "M"

Company Cities Service

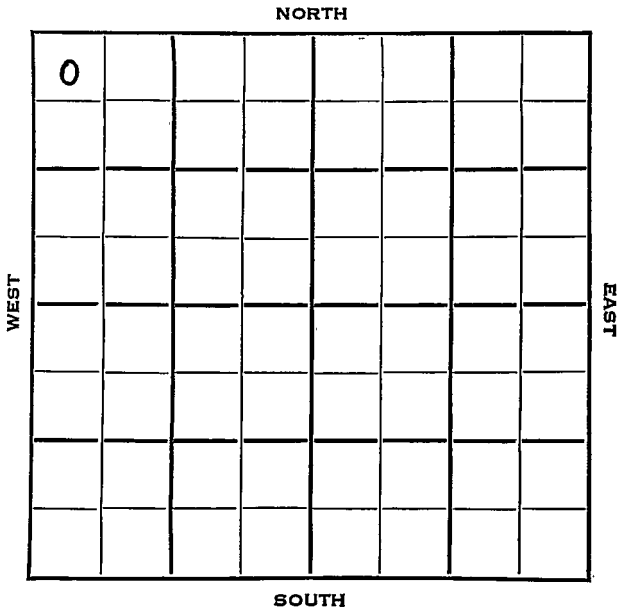

Stafford

KANSAS

SEC. 22	TWP. 22	R. 14W
------------	------------	-----------

WELL NO. #7 Smith "M" FARM

COMPANY Cities Service

CONTRACTOR Holm Drlg.


W. Oscar Pool

330 Ft. from N. Line

Ft. from S. Line

Ft. from E. Line

330 Ft. from W. Line

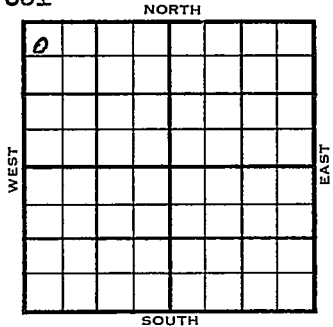

NW NW NW

	ELEVATION	REPORT
1954	1943'	
1/27		Location
2/17		8" @ 415' Heeb 3340', Br. L. 3469', Lans 3480' Drlg 3490'
2/24		DST 3595'-3612' 1 hr, 60' M & gco, 735# RTD 3635' 5" @ 3635' CO 3626
3/3		Spud 2-10-54 Oil well TD 3635 8" @ 415 Heeb 3340 Br. lime 3469 Lans. 3480 DST 3595-3612 open 1 hr rec 60' mud & GCO, 605' oil, 735# TD 3635 5" @ 3635 CO to 3626 16/3596-3611 27/3592-3600 P/28 BO 8 hr. 2000 A Comp. 492 BOPD
		COMPLETED

County Stafford State Kansas

Sec. 22 (Blk. 22 (Sur. 14W Map No. 22 (Twp. (Rge.

Operator Cities Service

Well No. 7 Farm Smith "M"

Elev. 1943 Location NW NW NW

0					

330 Ft. From N Line NW

330 Ft. From W Line Quarter

1st. Report

Completion MAR 3 1954

Remarks W. Oscar Pool

Holm Drlg. - Contr.

Spudding Date 2-10-54

Drlg. Data Oil well TD 3635

8" @ 415 Heeb. 3340 Br. line 3469

Lans. 3480 DST 3595-3612 open 1 hr.

Rec. 60' mud & gco 605' oil 735#

TD 3635 5" @ 3635 CO to 3626

16/ 3596-3611 27/ 3592-3600 P/ 28 bo

8 hr. 2000 A Comp. 492 bopd

J. G. McGEHEE