

Company R L Williams

A 10x10 grid with the following labels:

- Left side: WEST
- Right side: EAST
- Bottom: SOUTH
- Top-right cell: 6

KANSAS

Stafford

14W ✓

Sec. 22 Twp. 22 R. _____

Well No. #1 Prichard Farm _____
R. L. Williams Company _____

Wildcat


330' Ft. from N. Line

_____ Ft. from S. Line

330' Ft. from E. Line

_____ Ft. from W. Line

NE/C

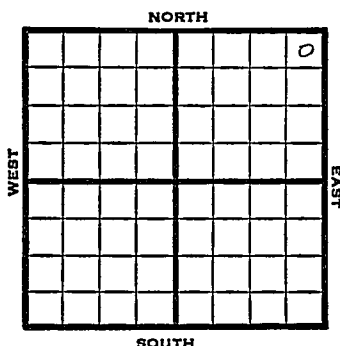

1948 **Eli 1939' REPORT**

11/10 8" @ 450
D lg. 1026'
11/16 Drlg. 3255'
11/23 Lansing 3456'
Arb. 3837'
TD 3843'
Viola 3759'
5" @ 3843'
11/30 TD 3850'
Plug 3724-
12 shots 3487-90'
250 acid
12/6 11,000 acid
12/14 "
12/22 "
12/29 1000 acid
Swb 5 bbls oil PH - 8 hrs.
1/5 4000 acid
swb 3/4 bbl oil @ 4 wtr 1 hr
1/12 24 shots 3616-24 CO
1/19 TD 3850'
Arb 3837'
Aband.

ABANDONED

Kansas

Map No. _____ Sec. 22 Twp. 22 R. 14W

Well No. 1 Prichard

R. L. Williams Company

FIRST REPORT Contractor

NE/C


SECTION PLAT

330 Ft. from N. Line

Ft. from S. Line

330 Ft. from E. Line

Ft. from W. Line

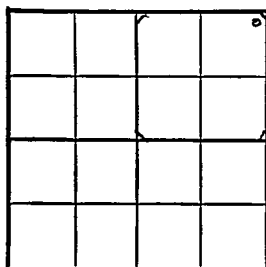

Stafford County

Location _____

Rig up _____

Drilling and Remarks: _____

8" @ 450

drlg. 1026

RECORD

Cased _____ in., _____ ft.

Sand _____

Gas _____

Oil _____

Total Depth _____

PRODUCTION

1st 24 hrs. Nat. _____

1st 24 hrs. after shot _____

Gas _____ Cu. Ft.

Dry Hole _____

Abandoned _____

Date

NOV 10 1948

19

S. J. LEWIS Scout

Kansas

Map No. 82 Sec. 22 Twp. 22 R. 14WWell No. 1 PrichardR. L. Williams

Company

ABANDONED

Contractor

NE/C

E. 1. 1939
SECTION, PLAT330 Ft. from N. Line Ft. from S. Line330 Ft. from E. Line Ft. from W. Line

Stafford County**RECORD**Location Cased in., ft.Rig up Sand

Drilling and Remarks:

Gas Oil Total Depth 3850**PRODUCTION**1st 24 hrs. Nat. 1st 24 hrs. after shot Gas Cu. Ft.Dry Hole Abandoned

Date

JAN 19 1949

19

S. J. LEWIS

Scout