


Section 22 Township 22 Range 14W

Well No. #3 Pritchard

Company Imperial Drlg.

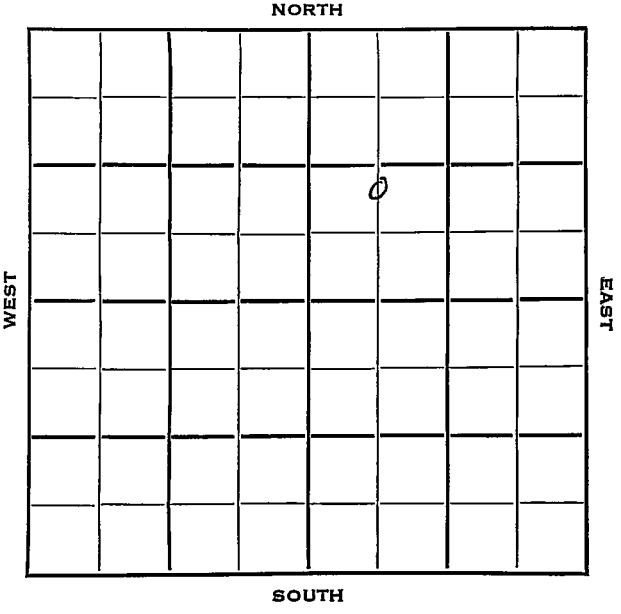

Sec. 22 Twp. 22 R. 14W

Well No. #3 Pritchard Farm

Imperial Drlg. Company

Imperial Contractor
West Oscar Pool


Ft. from N. Line

990 Ft. from S. Line

Ft. from E. Line

660 Ft. from W. Line

C N L SW NE

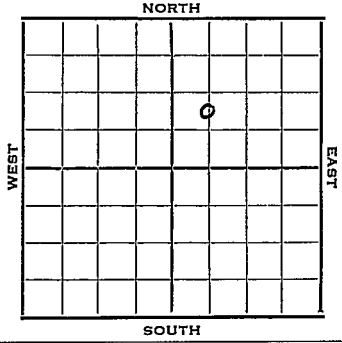

1953 Elev. 1941 REPORT

2/25 Spud 2-21-53
8" @ 262
Anhy 836
Drlg. 1890

3/12 "

3/19 "

3/25 Spud 2-21-53
Oil Well
TD 3623
8" @ 262
Anhy 836, Heeb 3320, Tor 3340,
Br Lime 3447, Lans 3458,
TD 3623 5" @ 3623 CO to TD
51/3580-89 F/19 boph 6000A
F/60 boph F/18 boph Comp. BH B
3000 bopd

COMPLETED

