
FORM 51

Stafford KANSAS

Section 22 Township 22 Range 14 W

Well No. # 6 Pritchard

Company Imperial Drlg.

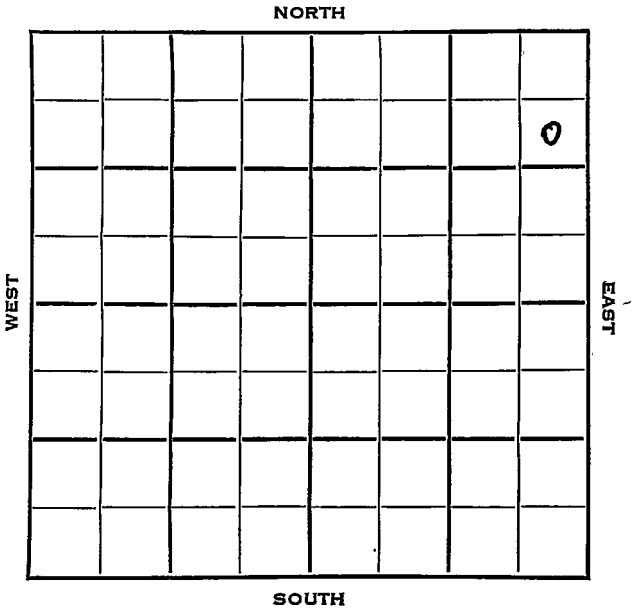

Stafford KANSAS

SEC.	TWP.	R.
22	22	14W

WELL NO.

6 Pritchard FARM

COMPANY

Imperial Drlg.

CONTRACTOR

Imperial Drlg.


990 Ft. from N. Line

Ft. from S. Line

330 Ft. from E. Line

Ft. from W. Line

SE NE NE

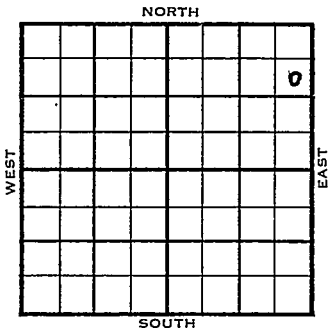

1953	ELEVATION 1937' REPORT
10/28	MIR
11/4	8" @ 225' Anhy 830' Drlg 2900'
11/11	Heeb 3323, Br. L. 3451, Lans 3463, DST 3577'-94' 1 hr, 640' oil no wtr 970# RTD 3596' 5" @ 3584'
11/18	CO 3596 S/ 5 boph 2 hrs. 5000 A S/ 190 BO 6 Hrs. F 26 BOPH 3 hrs.
12/22	Spud 10-28-53 Oil Well TD 3596' 8" @ 225' Anhy 830', Heeb 3323, Br. Lime 3451' Lans 3463' DST 3577'-94' opn 1 hr, rec 640' oil 970# TD 3596' 5" @ 3584' CO to 3596' S/ 5 boph 2 hr. 5000 A S/ 190 bo 6 h F/ 26 boph 3 hr. Comp 474 bopd COMPLETED

DX-78

FORM 275 FOR SALE BY KANSAS BLUE PRINT CO.

Kansas


County Stafford State

Sec. 22 (Blk. Twp.) 22 (Sur. Rge.) 14W Map No.

Operator Imperial Drlg.

Well No. 6 Farm Pritchard

Elev. Location SE NE NE

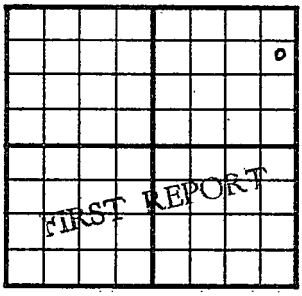

990 Ft. From N Line NE

330 Ft. From E Line Quarter

1st. Report OCT 2 8 1953

Completion

Remarks

Imperial Drlg. - Contr.

Spudding Date

Drlg. Data

M I R

J. G. McGEHEE

FORM 275 FOR SALE BY KANSAS BLUE PRINT CO.


County Stafford State Kansas

Sec. 22 (Blk. Twp.) 22 (Sur. Rge.) 14W Map No.

Operator Imperial Drlg.

Well No. 6 Farm Pritchard

Elev. 1937 Location SE NE NE

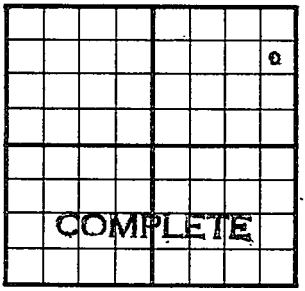

990 Ft. From N Line NE

330 Ft. From E Line Quarter

1st. Report

Completion DEC 22 1953

Remarks

Imperial - Contr.

Spudding Date 10-28-53

Drlg. Data Oil well TD 3596

8" @ 225 Anhy 830 Heeb. 3323

Br. lime 3451 Lans. 3463 DST 3577-94

open 1 hr. Rec. 640' Oil 970#

TD 3596 5" @ 3584 CO to 3596

S/ 5 boph 2 hr. 5000 A S/ 190 bo 6 hr.

F/ 26 boph 3 hr. Comp. 474 bopd

J. G. McGEHEE