


Section 22 Township 22 Range 14W

Well No. 1 Prichard "B"

Company Petroleum Inc.

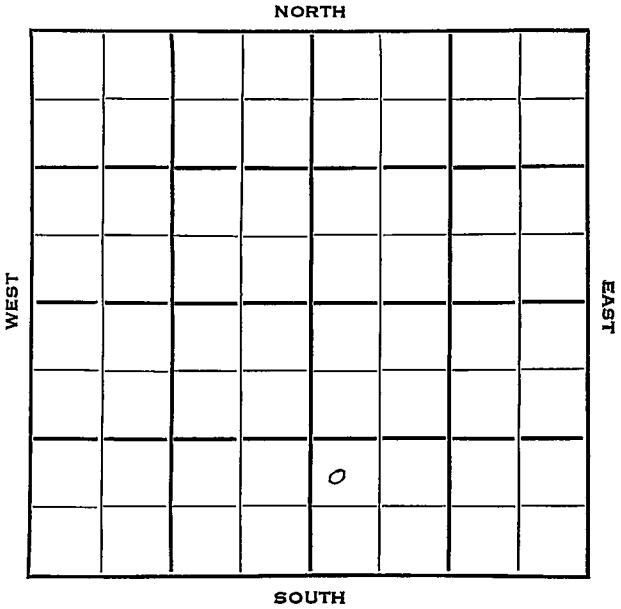

KANSAS ✓

Stafford

Sec. 22 Twp. 22 R. 14WWell No. 1 Prichard "B" FarmPetroleum Inc. CompanyGarvie - Contr. Contractor


Ft. from N. Line

990 Ft. from S. Line

Ft. from E. Line

330 Ft. from W. Line

NW SW SE

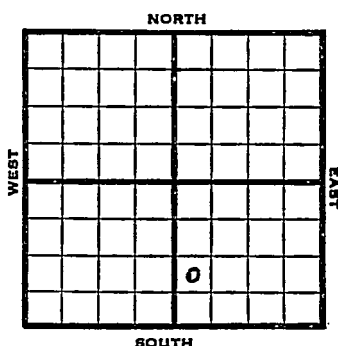

1953

Elev. 1955' REPORT


4/1

Location

4/8

Spud 3-29-53 D & A TD 3918'
 8" @ 251 Heeb 3355 Br line 3482
 Lans. 3493
 DST 3607-25 open 1 hr. rec 30' mud
 O#
 DST 3606-72 open 1 hr. rec 240' SOCM
 310# Cong. 3788 Viola 3822
 Simp. 3847' Arb. 3902
 TD 3918' D & A

ABANDONED

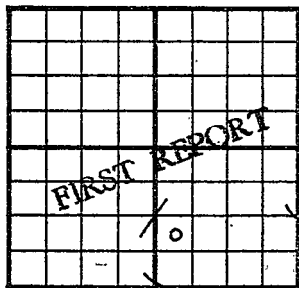County Stafford State KansasSec. 22 (Blk. Twp.) 22 (Sur. Rge.) 14W Map No. _____Operator Petroleum Inc.Well No. 1 Farm Prichard "B"Elev. _____ Location NW SW SE990 Ft. From S Line SE330 Ft. From W Line Quarter1st. Report APR 1 1953

Completion _____

Remarks _____


Garvie - Contr.

Spudding Date _____

Drig. Data _____

Location _____

County Stafford State Kansas
 Sec. 22 (Blk. 22) (Sur. 14W) (Rge. 14W) Map No. 14W
 Operator Petroleum Inc.
 Well No. 1 Farm Prichard "B"
 Elev. 1955 Location NW SW SE

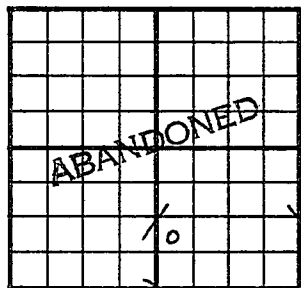

990 Ft. From S Line SE

330 Ft. From W Line Quarter

1st. Report

Completion APR 8 1953

Remarks

Garvie - Contr.

Spudding Date 3-29-53

Drlg. Data D & A TD 3918

8" @ 251 Heeb. 3355 Br. lime 3482

Lans. 3493 DST 3607-25 open 1 hr.

Rec. 30' mud 0# DST 3606-72

open 1 hr. Rec. 240' socm 310#

Cong. 3788 Viola 3822 Simp. 3847

Arb. 3902 TD 3918

D & A

J. G. McGEHEE