
FORM 51 25M 8-50 WESTERN Stafford KANSAS

Section 22 Township 22 Range 14 W

Well No. # 1 Smith (M)

Company Cities Service Oil

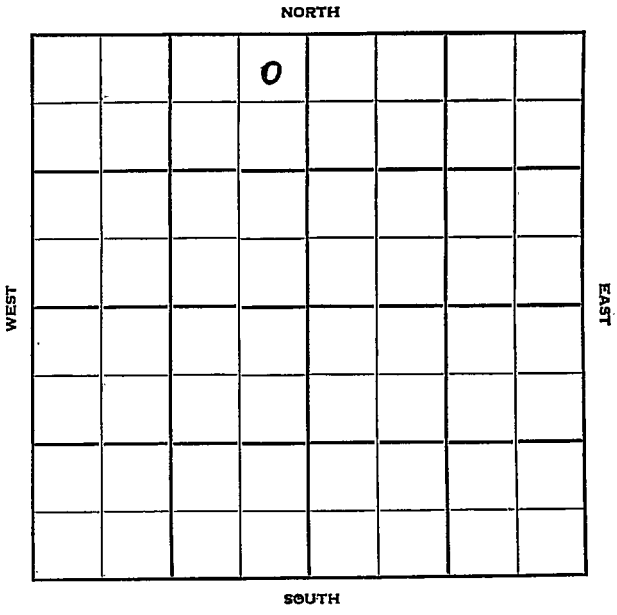

FORM 252-B
10M 8-51 TPCO.

Stafford

KANSAS ✓

Sec. 22 Twp. 22 R. 14W

Well No. #1 Smith (M) Farm

Cities Service Oil Company

Holm - Contr.
Smallwood Contractor


330' Ft. from N. Line

Ft. from S. Line

330' Ft. from E. Line

Ft. from W. Line

NE NE NW

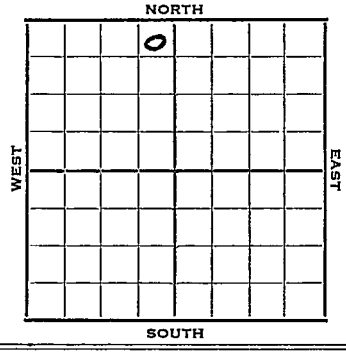

1952	Elev. 1941 REPORT
6/18	Location
6/25	8" @ 405' Drlg. 3020'
7/2	Br li 3454' Lans. 3466' DST 3581-97, 1 hr, 90' MCO, 2610' oil 1300# DST 3646-54, 1/2 hr, 30' M 650# RTD 3800' 5" @ 3800'
7/9	CO 3781' 66/3579-96 170' oil 1/2 hr. 2500' oil, 7 hrs. HF oil
7/17	F 41 BO 4 hrs thru casing F 29½ BO 3 hrs thru tubing 2000 A F/178 BO 6 hrs 1/4" chk
7/23	NR
7/30	"
8/6	Spud 6-18-52 Oil Well TD 3800 8" @ 405 Br Lime 3454 Lans. 3466 DST 3581-97 opn 1 hr. Rec. 90' mco 2610 oil 1300# DST 3646-54 opn ½ hr. Rec. 30' mud 650# TD 3800 5" @ 3800 Co to 3781 66/3579-96 FU 170' oil ½ hr. 2500' oil 7 hr. HFO F/41 bo 4 hr. F/29½ bo 3 hrs. 2000 A F/178 bo 6 hr. Comp. 2405 bopd **COMPLETED**

FORM 275 FOR SALE BY KANSAS BLUE PRINT CO.


County Stafford State Kansas

Sec. 22 (Blk. Twp.) 22 (Sur. Rge.) 14W Map No.

Operator Cities Service Oil

Well No. 1 Farm Smith (M)

Elev. Location NE NE NW

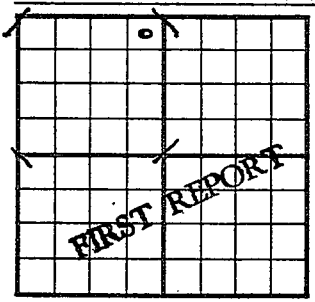

330 Ft. From N Line NW

330 Ft. From E Line Quarter

1st. Report JUN 18 1952

Completion

Remarks

Holm - Contr.

Spudding Date

Drlg. Data Smallwood

Location

J. G. McGEHEE

FORM 275 FOR SALE BY KANSAS BLUE PRINT CO.


County Stafford State Kansas

Sec. 22 (Blk. Twp.) 22 (Sur. Rge.) 14W Map No.

Operator Cities Service Oil

Well No. 1 Farm Smith "M"

Elev. 1941 Location NE NE NW

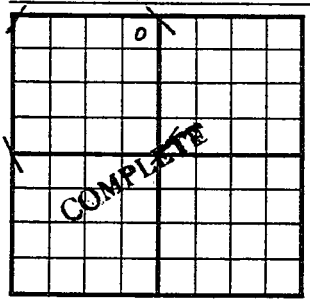

330 Ft. From N Line NW

330 Ft. From E Line Quarter

1st. Report

Completion AUG 6 1952

Remarks Smallwood Pool

Holm - Contr.

Spudding Date 6-18-52

Drlg. Data Oil well TD 3800

8" @ 405 Br. lime 3454 Lans. 3466

DST 3581-97 open 1 hr. Rec. 90' mco

2610' oil 1300# DST 3646-54 open ½ hr.

Rec. 30' mud 650# TD 3800 5" @ 3800

CO to 3781 66/ 3579-96 FU 170' oil ½ hr

2500' oil 7 hr. HFO F/ 41 bo 4 hr.

F/ 29½ bo 3 hr. 2000 A F/ 178 bo 6 hr.

Comp. 2405 bopd

J. G. McGEHEE