


Section 22 Township 22 Range 12W

Well No. 3 Smith "M"

Company Cities Service Oil Company

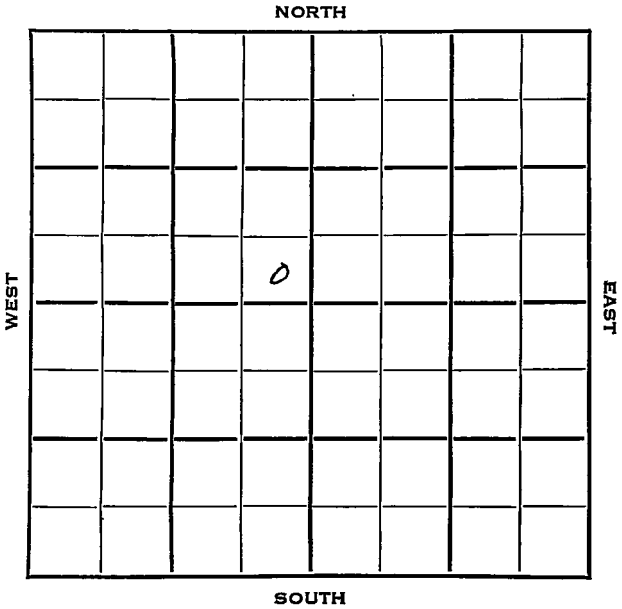

Sec. 22 Twp. 22 R. 11W

Well No. 3 Smith "M" Farm

Cities Service Oil Company

Holm Drlg. Cont. Contractor


         Ft. from N. Line

330 Ft. from S. Line

330 Ft. from E. Line

         Ft. from W. Line

SE SE NW

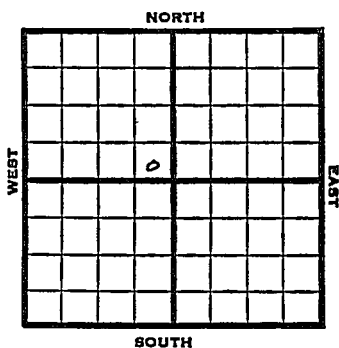

1953 Elev. 1944' REPORT

- 1/7 Spudding Date 1/4/53  
8" @ 410 WOC
- 1/22 Heeb 3332, Br Li 3462, Lans 3473  
DST 3587-3601, 10 mins., 120'  
M&GCO, 450' O&GCM, 120' M  
DST 3583-3601, 1 hr., 60' GCO  
640' G&MCO 915#  
RTD 3720  
5" @ 3720
- 1/29 B KC 3713' CO 3701' 57/3590-3604  
2900' oil 20 hrs. P/109 BO 2000 A  
P/131 BO 18 hrs.
- 2/4 Spud 1-4-53  
Oil Well  
TD 3720  
8" @ 410  
Heeb 3332, Br lime 3462, Lans 3473  
DST 3587-3601, opn 10 mins., rec. 120' mud & gco, 450' O&GCM, 120' mud  
DST 3583-3601, opn 1 hr., rec. 60' gco, 640' G&MCO 915#  
TD 3720  
5" @ 3720,  
B-KC 3713'  
CO to 3701 57/3590-3604

OVER

#3 Smith "M"  
(Information Brought Forward)

1953

2/4

FU 2900' oil 20 hrs.

P/109 bo 2000A

P/131 bo 18 hrs.

Gomp. 1526 bopd

**COMPLETED**



County Stafford State KANSAS

Sec. 22 (Blk. Twp.) 22 (Sur. Rge.) 14W Map No.

Operator Cities Service

Well No. 3 Farm Smith "M"

Elev. 1944 Location SE SE NW


330 Ft. From S Line NW

330 Ft. From E Line Quarter

Ist. Report

Completion FEB 4 1953

Remarks

Holm Drlg. - Contr.

Spudding Date 1-4-53

Drlg. Data Oil well TD 3720

8" @ 410 Heeb. 3332 Br. line 3462

Lans. 3473 DST 3587-3601 open 10 min.

Rec. 120' mud & gco 450' o & gcm

120' mud DST 3583-3601 open 1 hr.

Rec. 60' gco 640' g & mco 915#

TD 3720 5" @ 3720 B KC 3713

CO to 3701 57/ 3590-3604 FU 2900' oil

20 hr. P/ 109 bo 2000 A P/ 131 bo

18 hr. Comp. 1526 bopd

J. G. MCGEHEE