Stafford


FORM 51

KANSAS

Section 22 Township 22 Range 14 W

Well No. 4 - Smith "M"

Company Cities Service

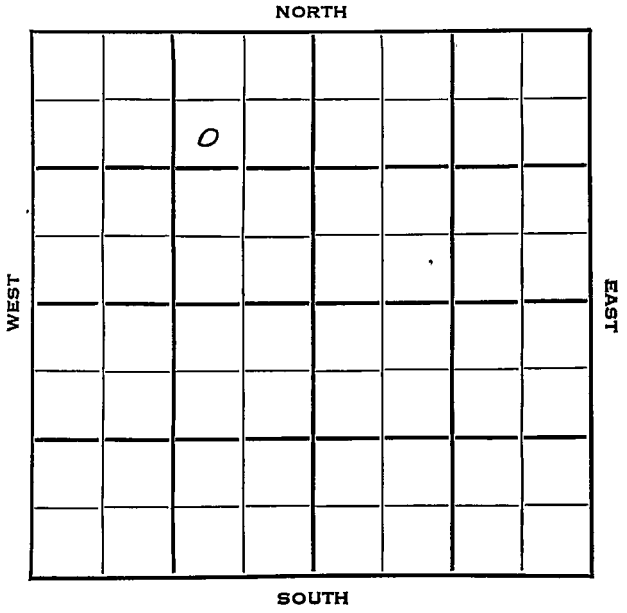

FORM 252-B

Stafford KANSAS ✓

Sec. 22 Twp. 22 R. 14 W

Well No. # 4 Smith "M" Farm

Cities Service Company

Contractor


990 Ft. from N. Line

Ft. from S. Line

990 Ft. from E. Line

Ft. from W. Line

SW NE NW

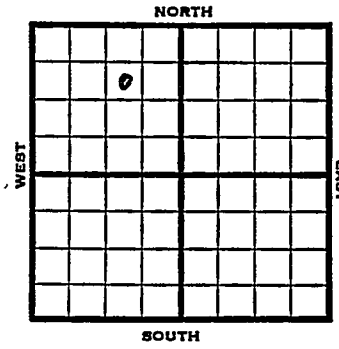

REPORT

1953	Elev. 1945'
1/21	Spud 1-18-53 8" @ 410' Drlg.
1/29	Drilling
2/5	Heeb 3332, Br li 3464, Lans 3474 DST 3588-3604, 1 hr., 300' M & GCO, 825' GCO, 889# DST 3608-30, 1 hr., 14' M RTD 3664 5" @ 3664
2/12	CO 3645 17/3588-3604, 23/3596-3604 24/3588-95, P/108 BO 15 hrs., 3000A, P/265 BO ¼ 40 BW 17 hrs.
2/18	Spud 1-18-53 Oil well TD 3664' 8" @ 410 Heeb 3332' Br. li 3464' Lans. 3474' DST 3588-3604 open 1 hr. rec 300' mud & GCO, 825' GCO 889# DST 3608-30 open 1 hr. rec 14' mud 0# TD 3664 5" @ 3664 CO to 3645 17/3588-3604 23/3596-3604 24/3588-95 P/108 BO 15 hr. 3000 A P/265 BO 40 BW 17 hr. Comp. 1850 BOPD COMPLETED

FORM 275: FOR SALE BY KANSAS BLUE PRINT CO.


County Stafford State Kansas

Sec. 22 (Blk. Twp.) 22 (Sur. Rge.) 14W Map No.

Operator Cities Service

Well No. 4 Farm Smith "M"

Elev. Location SW NE NW

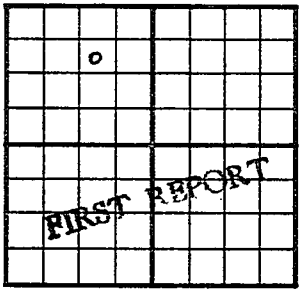

990 Ft. From N Line NW

990 Ft. From E Line Quarter

1st. Report JAN 21 1953

Completion

Remarks

Spudding Date 1-18-53

Drlg. Data

8" @ 410 drlg.

J. G. McGEHEE

FORM 275 FOR SALE BY KANSAS BLUE PRINT CO.


County Stafford State Kansas

Sec. 22 (Blk. Twp.) 22 (Sur. Rge.) 14W Map No.

Operator Cities Service

Well No. 4 Farm Smith "M"

Elev. 1945 Location SW NE NW

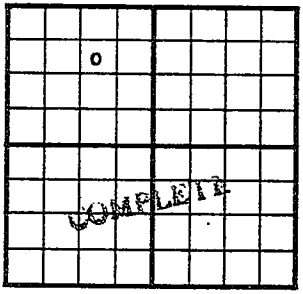

990 Ft. From N Line NW

990 Ft. From E Line Quarter

1st. Report

Completion FEB 1 8 1953

Remarks

Spudding Date 1-18-53

Drlg. Data Oil well TD 3664

8" @ 410 Heeb. 3332 Br. lime 3464

Lans. 3474 DST 3588-3604 open 1 hr.

Rec. 300' mud & gco 825' gco 889#

DST 3608-30 open 1 hr. Rec. 14' mud 0#

TD 3664 5" @ 3664 CO to 3645 17/ 3588-

3604 23/ 3596-3604 24/ 3588-95

P/ 108 bo 15 hr. 3000 A P/ 265 bo

40 bw 17 hr. Comp. 1850 bopd

J. G. McGEHEE